

DOUGLAS COUNTY FOREST APPRAISAL DEPARTMENT
 REPORT OF SURVEY CORNERS FOUND

Date June 6, 1956

Tp. 22 S. Rge. 9 W., W.M.


Corner Found NW Cor

Photo Location _____

Evidence of Corner Found 1 1/2" I. Pipe
with cap marked

about 2 ft out of ground

Corner Location in Reference
 to Terrain and Cover _____

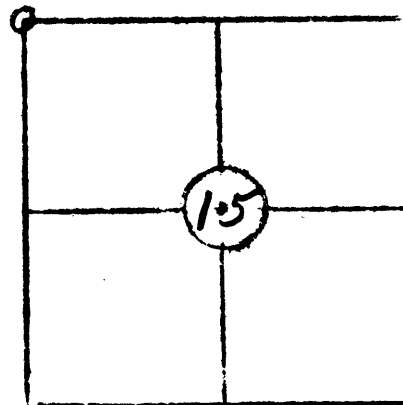

BEARING TREES FOUND

Quadrant	NE	NW	SW	SE
Dist. & Brg. From Corner	<u>N 81° E 39' 11.5"</u>		<u>S 44° 30' W</u>	
Species & Size	<u>24" Cedar</u>		<u>Maple</u>	
Condition of Scribe or Scar	<u>POOR</u>		<u>No Scribe</u>	
Original or Resurvey BT	<u>orig</u>		<u>orig</u>	
Appearance of BT			<u>a hole in tree</u>	
Tags, Marks, Etc. on BT	<u>TAG on BT</u>			

OTHER INFORMATION _____

MARKS OR TAGS LEFT AT
 CORNER OR NEARBY _____

DESCRIPTION OF LINES LEADING TO CORNER blazed line TO EAST

HOW CAN CORNER BE BEST REACHED: _____

REMARKS: _____

NAME Wilford H. Haines