

6-2-53

Section Corner 20-21-28-29,
T 305, R 4W, W.M. as det. by O.B.T.

A 35" B.O. bears N2W 121.0' O.B.T.

A 26" W.O. bears N3E 126.0' O.B.T.

A 14" W.O. bears S34E 55.0' O.B.T.

At corner point set 1x30" pipe
with 6 1/2" flange up.

from which

A 8" W.O. bears S42E, 23.4'
dist. mkd. S28 B.T.


A 10" W.O. bears N54W 18.2' dist.
mkd. S20 B.T.

A 12" W.O. bears N17E 13.0'
dist. mkd. S21 B.T.

Fence Corner bears N77W, 25.0'

Witness

B. E. Blomgren

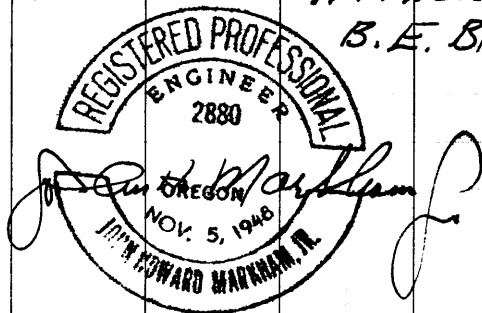

Work done for Stroman Lbr Co.

2/1/61 3