

6-9-53

Renewal of Renewal

1/4 Section Corner 19/30,  
T30S, R4W, W.M. as det. by O.B.T.S

A 24" Fir bears N80E 11.0'

A 30" Fir stump bears S45W 44'

A 30" Fir bears S45E 46'

At cor. pt. set 1'x30" I.P.

from which

A Maple 13" diam. bears SZW

13 1/2' dist. mhd. 1/4 S 2880 B.T.

There is a fence running N & W  
from corner.


Sec. Line bears S 82° W

Sec. Line bears S 87° 30' E

(Var. 20° 00')

Witness:

B. E. Blomgren

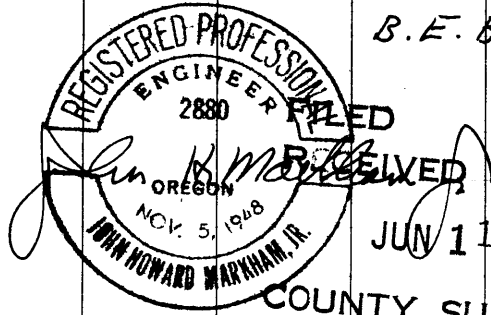

JUN 11 1953

COUNTY SURVEYOR  
DOUGLAS COUNTY, ORE.

Work done for Stomer Lbr. Co.

41/161-5