

6-10-83

S.W. Cor. of D.L.C. #40, T305, R4W
W.N. as det. by O.B.T.

A 16" W.O. Stump bears N8E,
99.0' dist. O.B.T.

At cor. pt. found large square
stone & drove 1" x 30" I.P.

from which

A W.O. 10" diam. bears N3E, 93.0'
dist. mhd. D.L.C. AD B.T.


A 16" B.O. bears S8E, 373.0'
dist. mhd. CL. 40 B.T.

S.E. Cor. CL #37 bears South
669.0'

Fence runs N + S from cor.

Witness

B. E. Blomgren

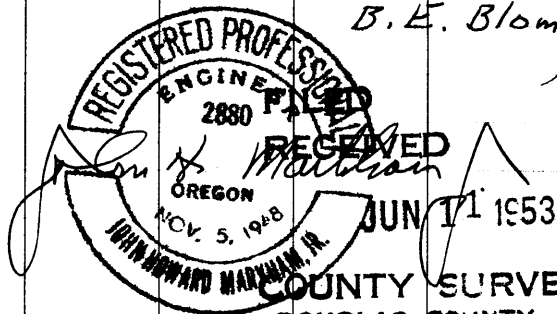

COUNTY SURVEYOR
DOUGLAS COUNTY, ORE.

Work done for Stoman Lbr. Co.

4/161-6