

6-10-53

1/4 Section Cor. 19/20, T305, R4W
W.M. as det. by O.B.T.

At cor. pt. Found 3' pile
of stones & drove 1x30" I.P.
from which

A 12" La. Sngg bears S10°W
28.0' dist. O.B.T. found scribe.

A 8" Pine bears S11W, 17.0'
dist. mkd. 1/45 B.T.


A 12" La. bears N6W 24.0'
dist. mkd. 1/45 B.T.

A 16" La. bears N48E 68.0' dist.
mkd. 1/45 20, T305, R4W 2880 B.T.

Fences run E & W from cor.
Cor. lies top of spur ridge.

Witness:

B.E. Blomgren

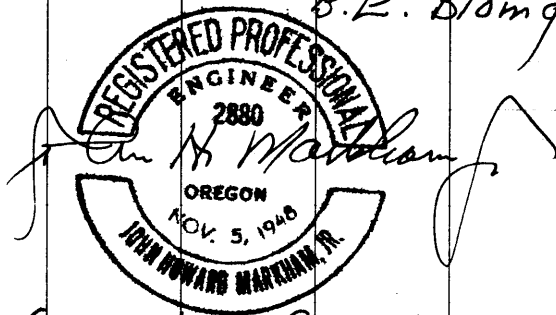

Work done for Stoman Lbr. Co.

4/161 - 7