


T 29S R 3W SEC. 28  
REESTABLISHMENT OF  $\frac{1}{4}$  COR 29+28  
FOR RALPH DUNCAN

JULY 1, 1956

FINDING NO TRACE OF ORIGINAL  
 $\frac{1}{4}$  COR I RESET COR. AT MID-POINT  
ON TRUE SEC-LINE, AFTER MEASURING  
SEC. LINE BET. 29+28.

SET A  $\frac{3}{4}$ " I. PIPE, SCRIBE:  
12" MADRONIE, S 63° 40' E, 1.6 FT.  
1 1/2" W. FIR, N 69° 50' W, 42.3 FT.

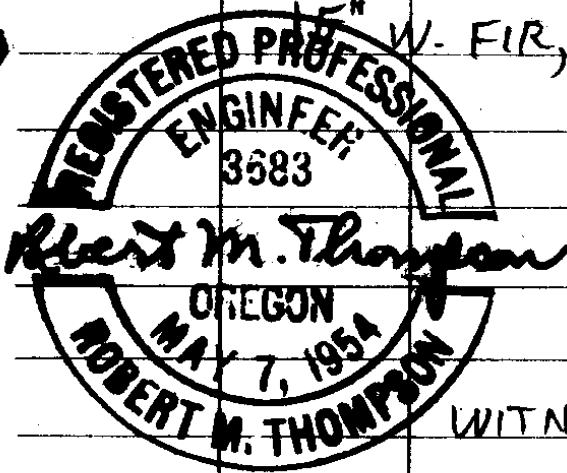

Robert M. Thompson  
REG. ENGR.

WITNESS:

RALPH DUNCAN

ROY DUNCAN

F. HOLTZCLAW

H. BENSON

C. S. File No.

42/178

105770