

Nov. 27, 1956

N.W. Corner Benj. J. Stephens  
D.L.C. #38, T29S, R4W, W.N.

At a point 10160' South of the  
N.E. Corner of the H. Weaver D.L.C. #39  
I found stone set by County in  
1938.

At corner point I set  $3\frac{1}{4}$ " x 36"  
iron rod 24" in ground,  
from which

A 10" Fir bears N20°E 35.0' dist.  
mkd. CL 38 B.T.


A 12" W.O. bears S36½°W 58.7'  
dist mkd. CL 39 T29S R4W B.T.

A 12" square marble grave stone  
bears S89°E 285.0' dist mkd.  
Benjamin J. Stephens Born Aug. 24, 1820

Died June 18, 1896

Fence bears N-S from corner.

Witness: Bob Boyd

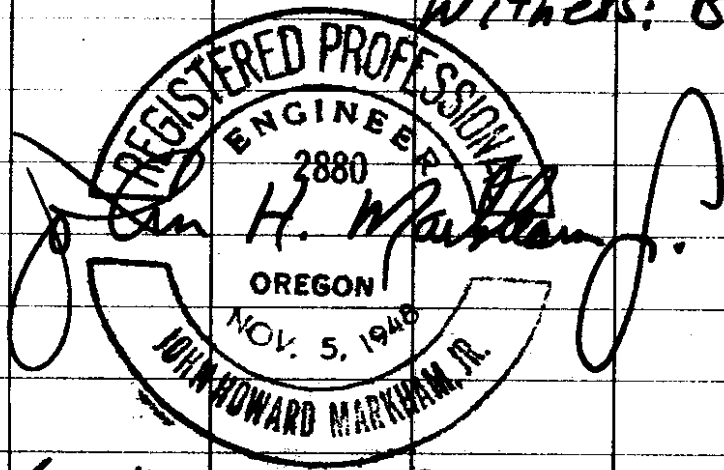

C. S. File No. 782/1845

Work done for Stomar Lbr. Co.