

T 275 RBW W.M.

SEC COR 35/36

SET FROM TESTIMONY OF  
ARTHUR M. MATTHEWS:


AT CORNER POINT SET  $\frac{3}{4}$ " IRON  
ROD WITH STAKE ALONG-SIDE

NO BRASSING TREES AVAILABLE

DRIVE CLIMBERS ROCK NAIL IN  
CLIFF FACE  $54^{\circ}00'E$  16 FT 0.32

ROCK NAIL HAS CIRCULAR HEAD  
WITH 1" DIAMETER STEEL RING  
ATTACHED.

DIETZGEN NO. 385-6

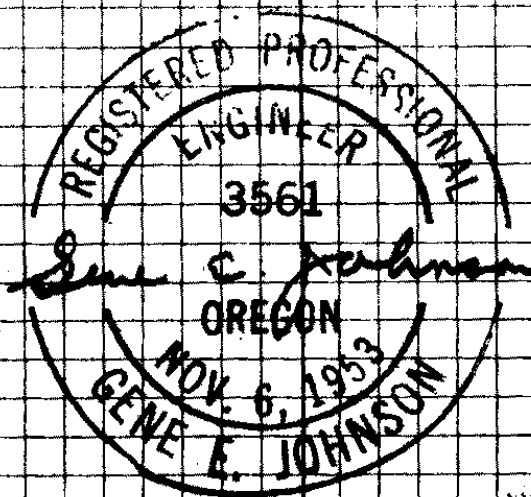

WITNESSES: FRED WILSON  
ARTHUR MATTHEWS

MARCH 15, 1955

C. S. File No. 42/194/1

March 22, 1955

TESTIMONY:

I, Arthur M. Matthews testify that I have seen a post-standing for the (South) C.C. between Sec. 36 & 35 (27-8) and showed the same place to Gene E. Johnson.

It is and has been the understanding of me, my father and grand father (Albert A. Matthews - home steading) that this post is & was the corner for sec 35 and 36. T 27 S R 8 W W.M.

*Arthur M. Matthews*  
ARTHUR M. MATTHEWS  
REGISTERED PROFESSIONAL ENGINEER  
3561  
*Gene E. Johnson*  
GENE E. JOHNSON  
OREGON  
NOV. 6, 1953

Witness: *Fred R. Weber*

C. S. File No. 42/194-1