

T 27 S , R B W , W. M.

SOUTH 1/4 CORNER SEC 36

SET FROM O. B. T. 12" OAK (Now 14")
N73°E 6.0 LKS. BT VERY ROTTEN.
SCRIBE VISIBLE

AT COR. POINT SET 3/4" IRON
ROD, FROM WHICH.


O. B. T. 14" OAK BEARS N73°E 6.0 LKS

NEW. B. T.'S

14" OAK BEARS NB2°00'W 90.0 FT
DIST SCRIBED 1/4 S 36 BT RE3561

12" OAK BEARS N11°15'E 67.0 FT. DIST.
SCRIBED 1/4 S 36 BT RE3561

DIETZGEN NO. 385-6

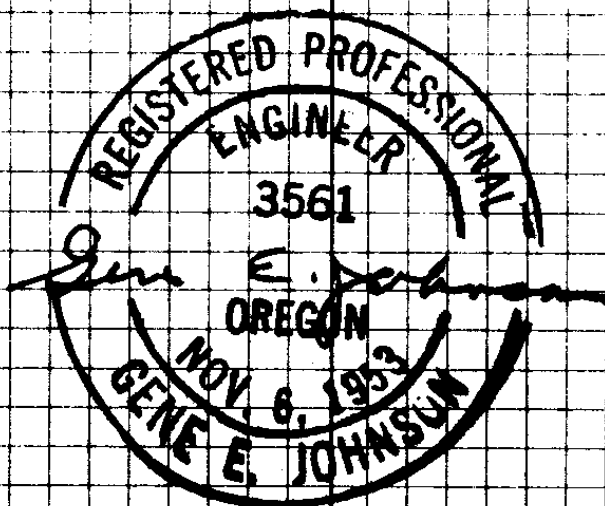

MARCH 15, 1955

WITNESS - FRED WEBER

C. S. File No.

42/194-2