

T 26 S, R 8 W W.M.

SEC COR 22/23 OCT 30, 1955
27/26

FOUND 48" FIR SNAG S 61° W
155 LBS. DIST. OLD SCRIBE
MARKS GOOD - THIS TREE SUPPOSED
IT WAS DESTROYED BY FIRE PRIOR
TO 1898 RETRACEMENT

FD ROTTEN FIR SNAG S 5 1/2° E
170 LBS - NO SCRIBER MARKS - TOO
ROTTEN

FD STUMP HOLE N 35° W, 135
LBS DIST.

HOUSE SITS ON POSITION ON
N.E. TRAP - 14" FIR, N 62° E
260 LBS DIST - JOHN HANLEY
STATED THAT AT TIME HE BUILT
HOUSE HE DESTROYED TREE

AT COR POINT SET STAFF
COR JACK WITH 1" STAFF EXPOSED
6" ABOVE GROUND, FROM WHICH

P.B.T. 48" FIR SNAG BEARS S 61° W
153 LBS DIST

NEW B.T.'S

15" D. FIR BEARS N 41° 30' E, 11.20
FT DIST SCRIBED T26S R8W S 23 BT
RE 3561

17" D. FIR BEARS S 61° 00' E 15.70 FT
DIST SCRIBED T26S R8W S 26 BT
RE 3561


17" D. FIR BEARS S 64° 15' W 29.80 FT DIST
SCRIBED T26S R8W S 27 BT RE 3561

16" D. FIR BEARS N 40° 15' W, 14.80 FT
SCRIBED T26S R8W S 22 BT RE 3561

(OVER)

C. S. File No.

42/195

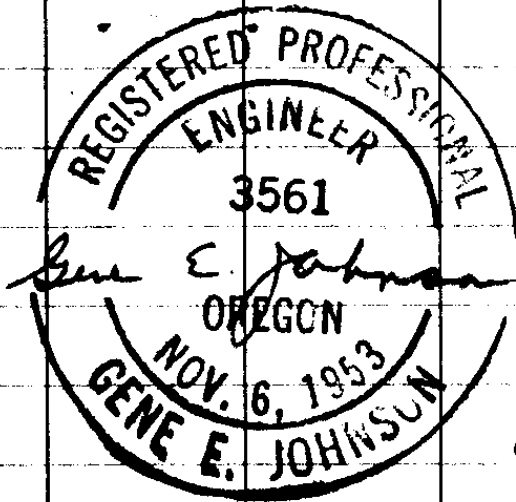

OCT 30, 1955

Witness: Fred Werner