

Re-establishment of Sec
Cor

$\frac{35}{2} | \frac{36}{1}$ T 305 - R 8 W.
T 315 - R 8 W

Set by proportionate meas.
between $\frac{1}{4}$ cor $\frac{35}{2}$ & $\frac{36}{1}$
(see record of survey)

Set 3" x 3" x 36" D. Fir stake -
Blaze & scribe B.T.s.

10" Madrone, S 78 $\frac{1}{2}$ ° E, 13 $\frac{3}{4}$ ft.

Mkd T 31, R 8, S-1 - RE 2791, B.T.

3" D. Fir, S 72° W, 6 $\frac{3}{4}$ ft

Mkd. 'X' - B.T.

8" Mad. N 51° E, 17 $\frac{1}{2}$ ft.

Mkd. T 30, R 8 W, S-36, RE 2741, B.T.

7" Mad. N 6° W, 17 $\frac{3}{4}$ ft.

Mkd T 30, R 8, S-35, RE 2741 BT

Witnesses: -


J. W. Oiler.

Jack Chapman

T. S. Harris.

For The Martin Bros.

Box Co - 4-19-56

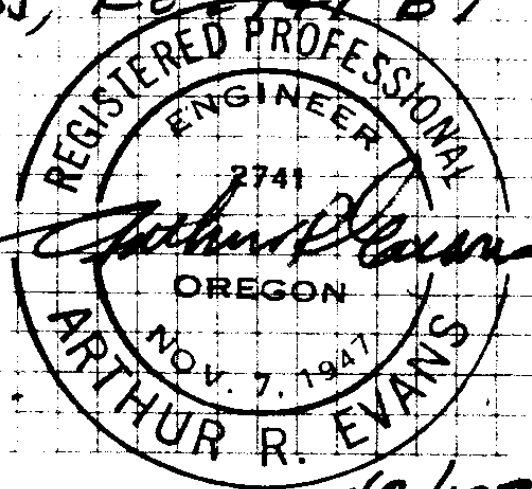

C. S. File No. 42/197!