

Re-establishment of

1/4 Cor 36 T305 - R8W

1 T315 - R8W.

2 O.B.T's.

24" Pine S 25° E, 18 lks.

Rotten snag -

30" Pine - N 60° E - down & rotten

Set 4" x 4" x 48" D. Fir post

Blaze & scribe 2 N.B.T's

6" W. Fir, N 36° E, 33 lks (inter right)

Mkd - 1/4 S - 36 - RE. 2741 B.T.

16" D. Fir, S 24° W, 27.5 lks. (not ft.)

Mkd - 1/4 S - 1 - RE 2741 B.T.

(See recorded survey)

Witnesses:


Jack Chapman

T.S. Harris

J.W. Oilar.

For The Martin Bros

Box Co. 4-18-56

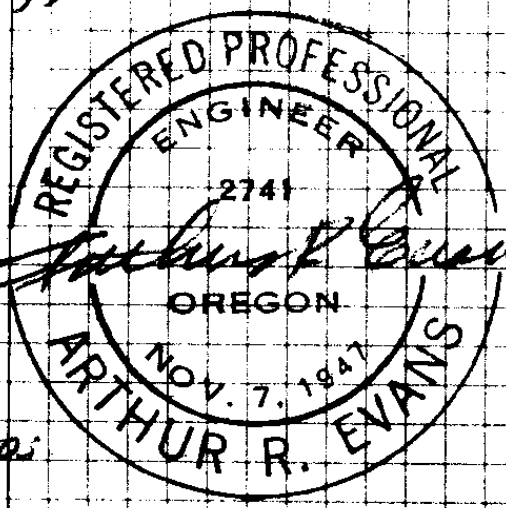

DIETZGEN NO. 385-S