

JAN 12, 1956

RENEWAL OF 1/4 CORNER

FOR SECTIONS 2/1

T305, R2W, W. M.

I FIND CORNER STONE  
IN POSITION AND MARKED  
B.T. IN SECTION 1 STAND-  
ING BUT WITH FACE

ROTTED OUT. NO TRACE  
OF FIR B.T. IN SECTION 2.

I SCRIBE 2 NEW B.T.'S  
AS PRESCRIBED BY LAW:


18" D. FIR, N84 1/2° W, 21<sup>9</sup> FT.

40" SUGAR PINE, N70° E, 47<sup>9</sup> FT.

R. M. THOMPSON, REG. ENGINEER

WITNESS: { R. L. BROWN

{ G. D. MYERS

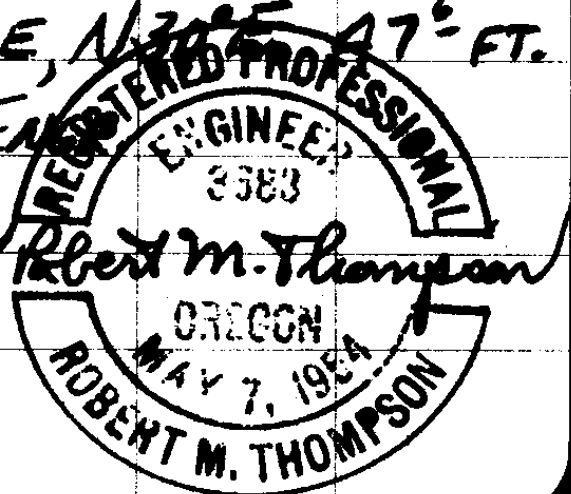

En. 2. File No. 42/199

AND