

DOUGLAS COUNTY FOREST APPRAISAL DEPARTMENT
 REPORT OF SURVEY CORNERS FOUND

Date 10-17-56


Tp. 21 S. Rge. 6 W., W.M.

Corner Found 1/4 S 21

Photo Location _____

Evidence of Corner Found Scribed
Cedar Stump

Corner Location in Reference
 to Terrain and Cover On South Slope
On Cutting Line

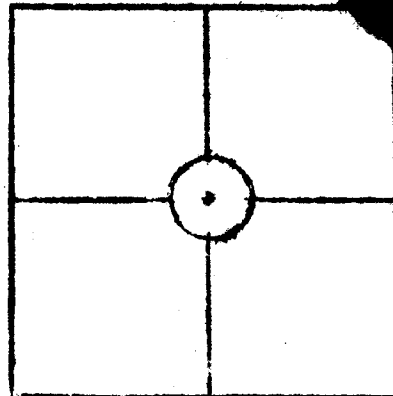

BEARING TREES FOUND

Quadrant	NE	NW	SW	SE
Dist. & Brg. From Corner		Missing		S 29° E, 66 Ft.
Species & Size				Incense ced 40"
Condition of Scribe or Scar				Good
Original or Resurvey BT				Original
Appearance of BT				STUMP
Tags, Marks, Etc. on BT				Cruisers marks

OTHER INFORMATION We could not locate N.W. B.T.

MARKS OR TAGS LEFT AT CORNER OR NEARBY I scribed 2 new B.T.'s and hung yellow BLM Tags on them. Put 1 iron rod (1" X 36") in ground with brass cap attached *

DESCRIPTION OF LINES LEADING TO CORNER Lines blazed E & W of Cor. Timber tagged in 28

HOW CAN CORNER BE BEST REACHED: Drive up Tom Folley Road

REMARKS: Two New B.T.'s
10" Fir, S 03° W, 19.3 Ft. (to S B.T. 363)
40" Fir, N 30° W, 60.7 Ft. (to S B.T. 363)

* Brass cap inscribed FILED
 "Wilford N. Haines RECEIVED
 Survey Pt.
 # 239"

NAME Leo J. Martin # 363

OCT 18 1956

COUNTY SURVEYOR
 DOUGLAS COUNTY, ORE.

C. S. File No. 42/208