



# LUOMA PARCEL SURVEY

JAMES R. DAUGHERTY  
 CIVIL-SANITARY ENGINEER  
 ROSEBURG, ORE.

SCALE 1" = 50'

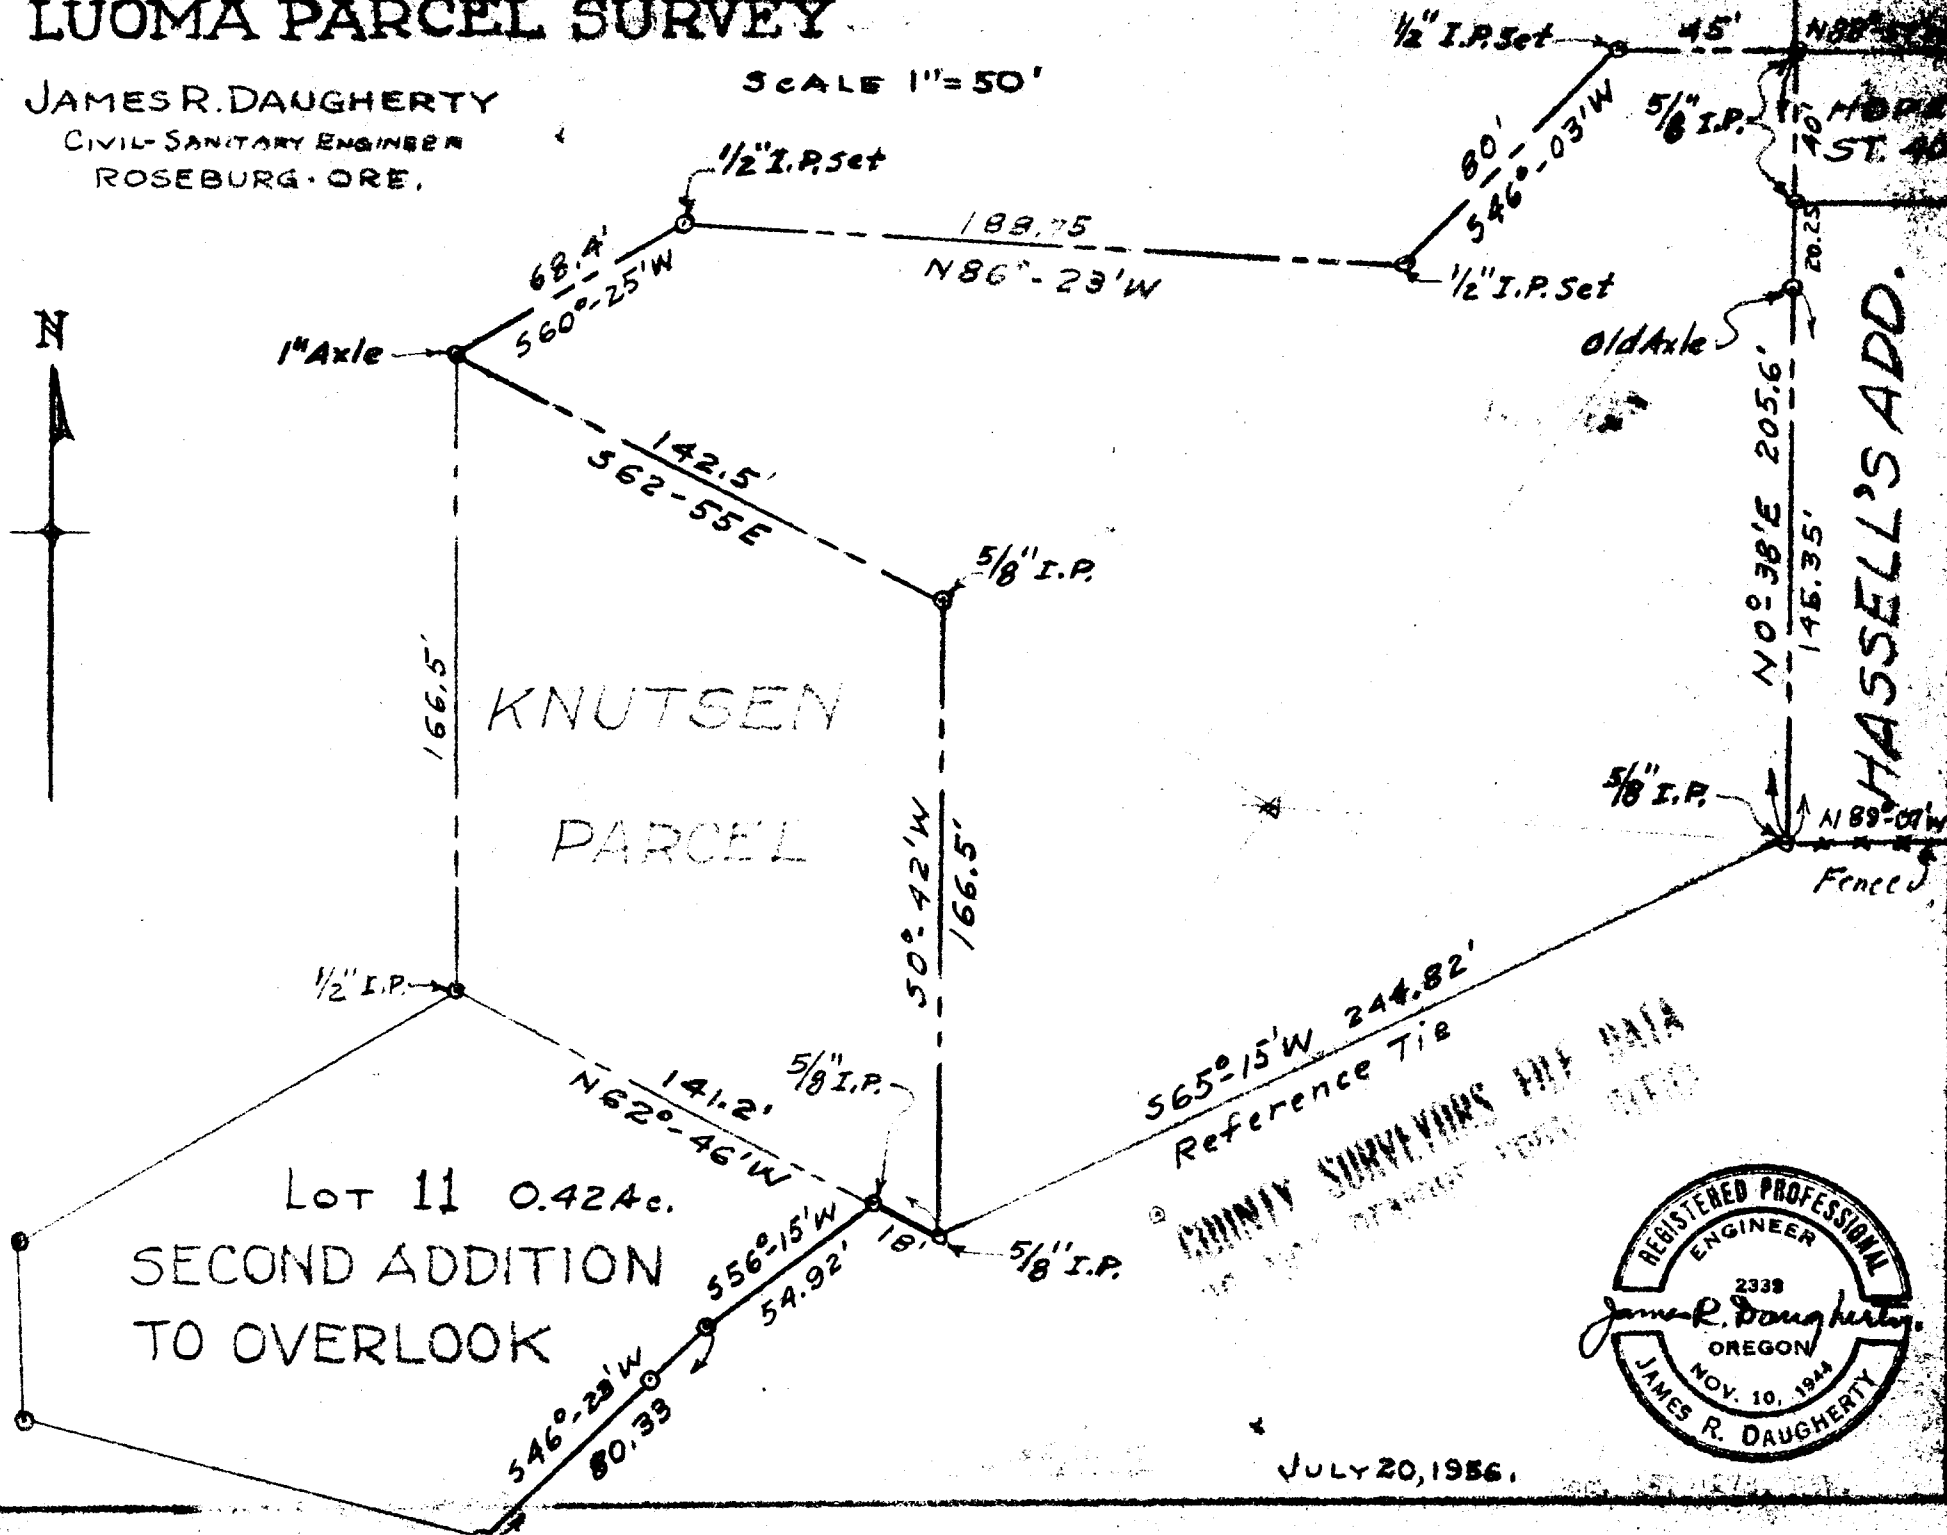

Reference Tie  
 S65°-15'W 244.82'  
 COUNTY SURVEYING FILE DATA

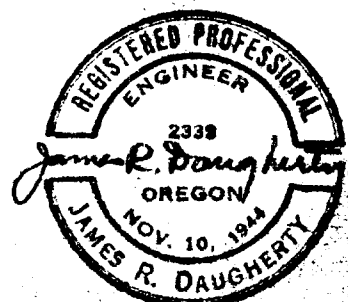

JULY 20, 1956.