


Prepared for
 ~ RALPH E. KINKADE ~
 showing
 Meets & Bounds description in Riddle, Oregon
 Scale 1" = 60' Jan. 1957

COUNTY SURVEYORS FILE DATA
 DO NOT REMOVE FROM OFFICE

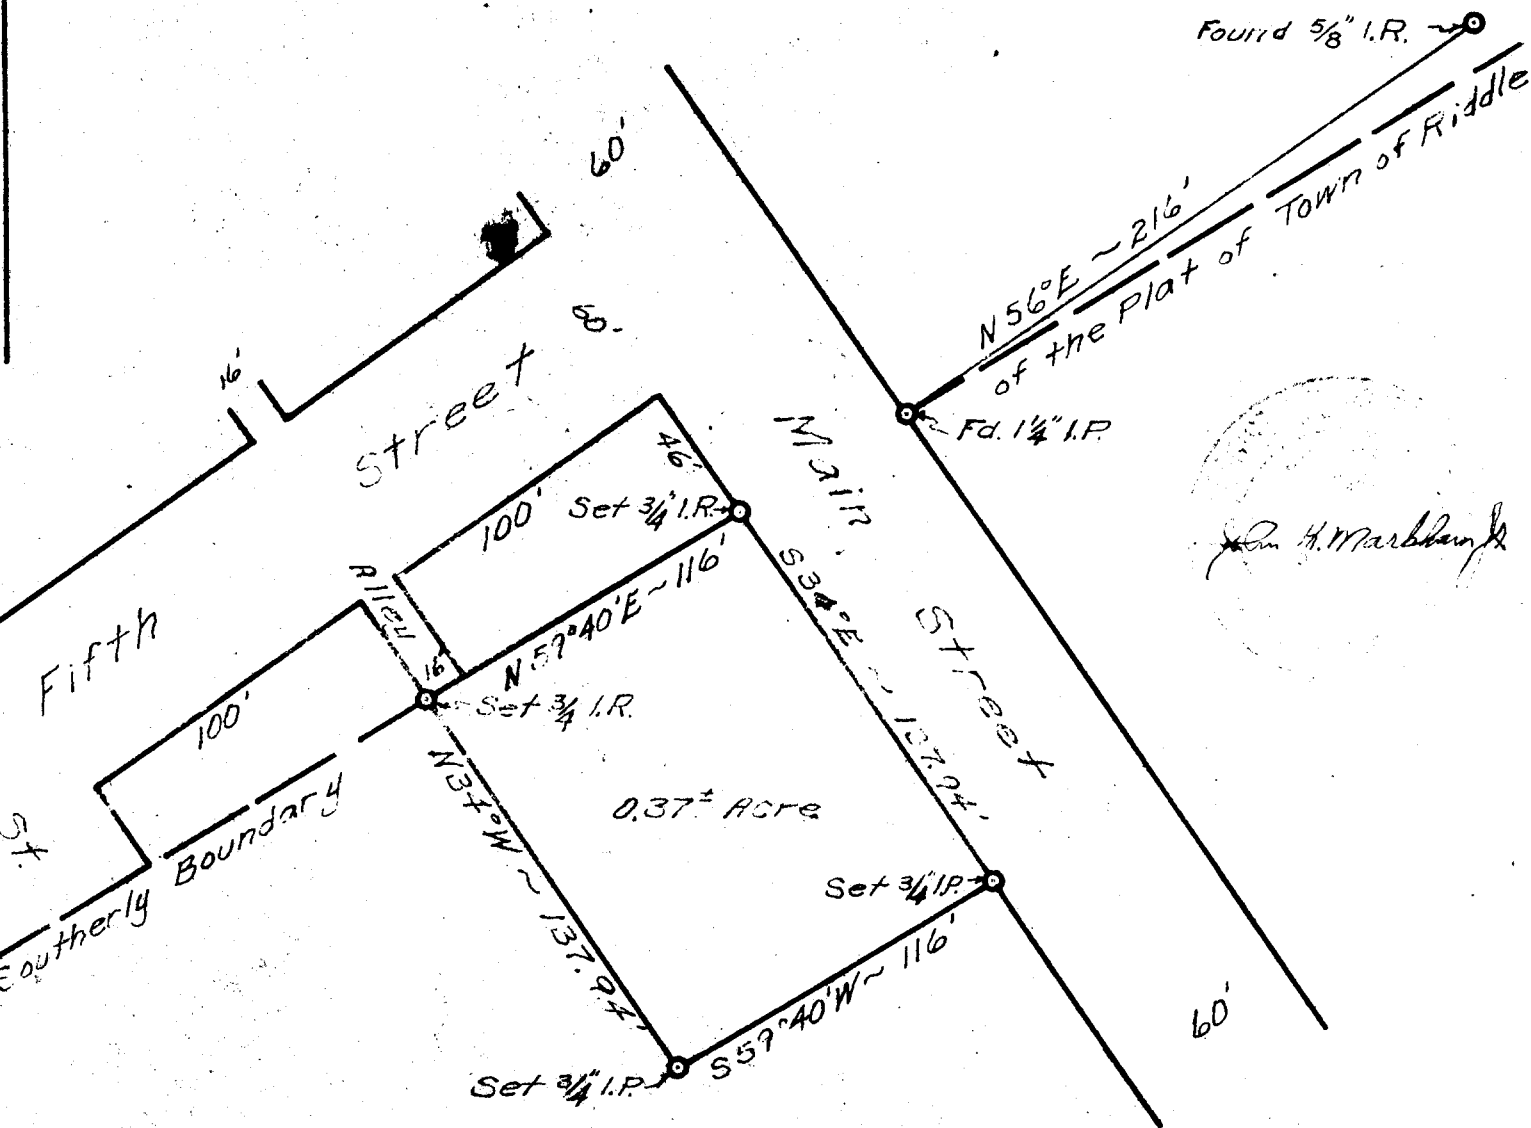

Don H. Marble