

Road destroyed all B.T.'s
Re-set from Reference by R.H. the.

Roseburg, O.C.
New Witness Trees
for the corner
to Sections

28, 29, 32, & 33 T.31S.R.6W

FIR 4" S 77 $\frac{1}{2}$ ° E 74⁸ ft.

FIR 6" S 42 $\frac{1}{2}$ ° W 66¹ ft.

FIR 4" N 38° E 36² ft.

FIR 4" N 4° W 76⁸ ft.

Scribed R.E. 3937 BT

$\frac{1}{2}$ " x 3' I.P.


Date 2/14/57

Witnessed by

R.G. Hennikarn

E.W. Danc

R.E. Morgan

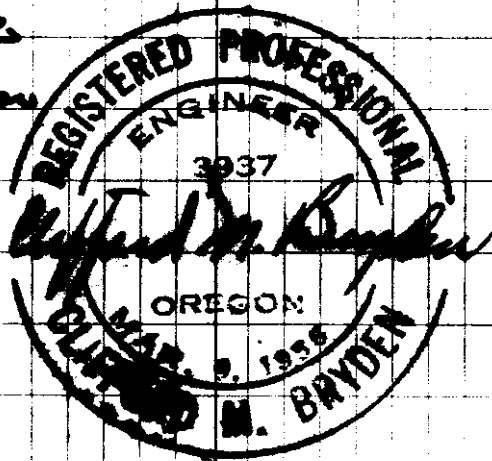

C. S. File No. 42/2501