

Rosburg Lbr. Co.

Re-newed Witness Tree
for the


1/4 Section corner
between
Sections 20 & 21
T. 31 S. R. 6 W

Old B.T. Cedar 18" S 62 1/2° W 7³ ft.

New B.T. Scribed R.E. 3937 BT
FIR 18" N 81° E 79° ft.
Set 2" x 4" x 4" Cedar post.

Date 2/14/57

Witnessed by
R. J. Henriksen
R. E. Morgan

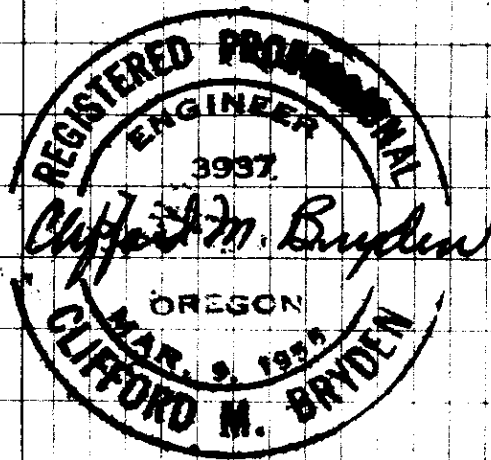

C. S. File No. 42/250-2