

JULY 29, 1956


W S

RENEWAL OF $\frac{1}{4}$ COR. 19+20

I FIND THE 2 ORIGINAL
BEARING TREES AS DESCRIBED
IN ORIGINAL G.L.O. FIELD
NOTES, BUT BOTH DEAD.

I RENEW BY SCRIBING NEW
BEARING TREES:

16" D. FIR, N 19° 40' W, 17.3'
16" D. FIR, S 48° 10' E, 14.9'

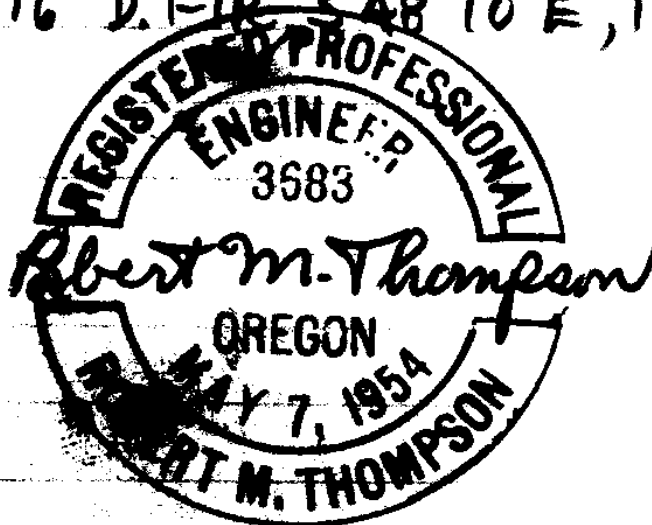

WIT.: G. BONNEY
J. BONNEY
E. WHETZEL

C. S. File No. 42/252