

5-23-57

1/4 corner Sec. 17-18, T30S
R6W, W.M. as det. by O.B.T.

At corner point found 1"
drill steel shaft & scribed
wood post in middle of stone.

At cor. pt. I set brass cap
in concrete mkd. T30S, R6W

1/4 S 18 S 17 2880 1957

from which

A 16" Pine bears N85°W 21.7'
dist. O.B.T. fd. scribe

A 27" Pine Stamp (logged)
bears S85°E 31.5' dist. O.B.T.
fd. scribe.

A 11" Pine bears N15°W 52.0'
dist. mkd. 1/4 S 18 B.T.

A 17" Pine bears S19°E 16.0'
dist. mkd. 1/4 S 17 B.T.

Logging road bears West
83.5' dist


Witness:

Carl D. Jenks

(OVER)

G.S. File No. 42/269-1

Work done for Hanna
Coal & Ore Co.

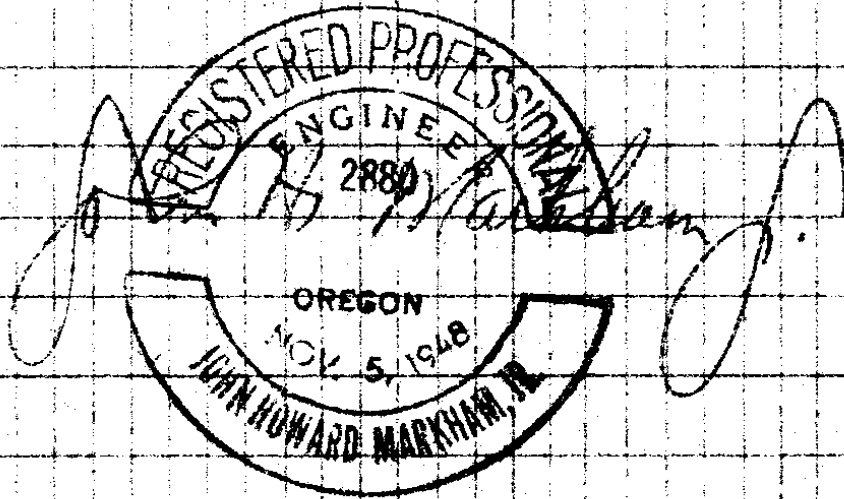

FILED
RECEIVED

JUN 6 1957

COUNTY SURVEYOR
DOUGLAS COUNTY, ORE.

NORTH

PREPARED FOR
HANNA COAL & ORE CO. INC.

