

6-13-57

Section Corner 17-18-19-20,
T30S, R6W, W.M. as det. by O.B.T.

A 15" Pine bears N50°W 4.0' O.B.T.

A 12" Pine S59W 31.0' O.B.T. fd. scribe

24" Pine N25°E 95.5' O.B.T. fd. scribe.

At corner point set brass
cap in concrete mkd: T30S

R6W, 17-18-19-20, 2880, 1957

from which

18" Pine bears N86°30'W 29.7'
dist. mkd 518 B.T.

A 32" Fir bears S40°W 54.2'
dist. mkd 519 B.T.

A 8" Pine bears S38°E 12.1'
dist. mkd 520 B.T.


Road bears North 183.0'

Witness:

Earl D. Jenks.

Work done for Hanna Coal & Ore

PREPARED FOR
 HANNA COAL & ORE CORP.

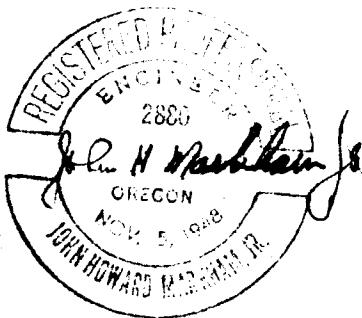

24" PINE
 O.B.T.

