


LOTS 9 & 10 · BLOCK 2 · BROWNS FAIR ACRES WEST ROSEBURG · DOUGLAS COUNTY · ORE.

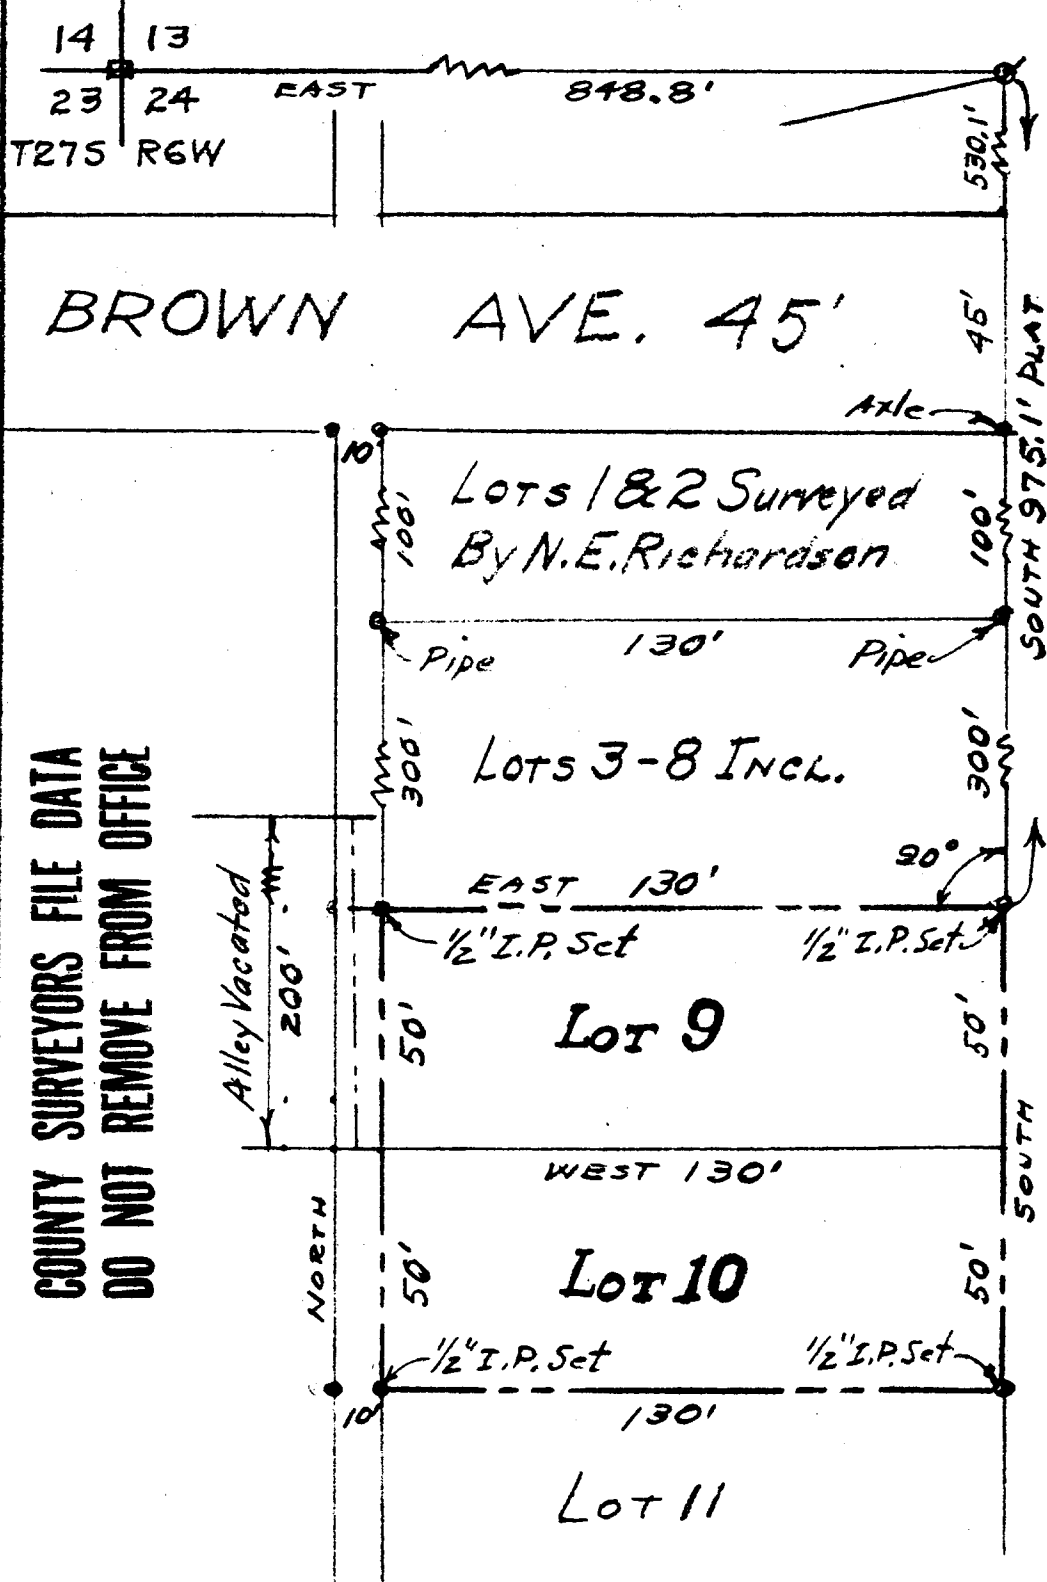

COUNTY SURVEYORS FILE DATA
DO NOT REMOVE FROM OFFICE


FILED
RECEIVED

JUL 11 1957

COUNTY SURVEYOR
DOUGLAS COUNTY, ORE.

SCALE 1" = 40'

SURVEYED BY
JAMES R. DAUGHERTY
 CIVIL-SANITARY ENGR.
 ROSEBURG · ORE
 FOR U.S. NATIONAL BANK

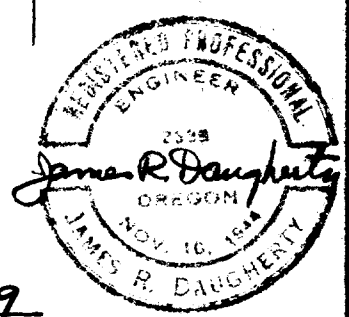

C. S. File No. 42/279

JUNE 25, 1957.