

T305 R6W Sec. 18

July 29, 1957

Kitchell M.S. #305 Corner
#3 and #5 which are common
as det by O.B.T.

8" Fir Snag bears S40E 5.2'
dist. O.B.T.

At corner point found large
pile of stone and set brass

cap in concrete mkd. M.S.
305 3 + 5 T305 R6W 2880 1957

from which

A 10" Fir bears S30W 33.4'
dist. mkd. M.S. 305 B.T.


A 14" Pine bears S33°E 22.0'
on slope mkd. M.S. 305 B.T.

1/4 cor. bears South 250 0'

Witness:

E. D. Jenks

G. D. Meyers

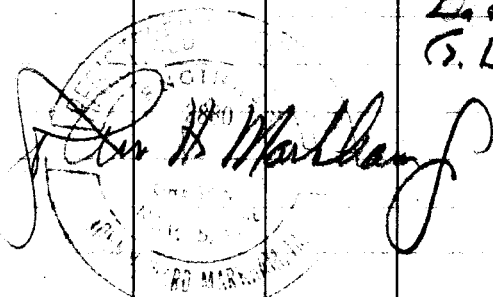

John H. Marshall

Work done for Hanna Coal & Ore.

Prepared For
Hanna Coal & Ore Corp.

At corner point found large pile of Stone.
Set brass cap in concrete Mkd. MS 305
3 & 5 T 305 R 6 W 2880 1957

