


Section 17 E 20 Twp 25S Rge 2 W

Date: 6/7/57

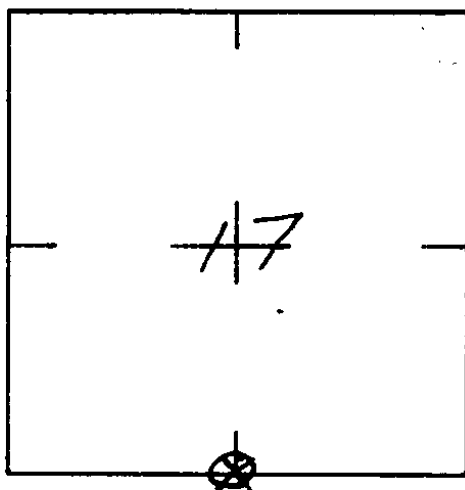

How was corner identified? S.W. B.T. & transit  
point on previous survey

Condition of corner: Original stone gone - 1 set 1 1/2"  
I.P. 36" long - 24" in ground

Best route to reach corner: Rock Creek road &  
Shoupe creek road

Quadrant	NE	NW	SE	SW
Species & Size		14" maple	17" Cedar	21" nor 30" Fir
Dist. & Bearing		N69°W - 14 ks	S40°E, 479'	S68°W 11 ks
Condition of Scribe		Destroyed	new	Covered
Original or Resurvey		in logging	resurvey	orig
Appearance of B.T.			good	good
Tags, Marks, etc.				USBLM

Other Remarks:

As no trees remain standing  
near in sec. 17, I marked  
new B.T. in sec. 20 and  
drove iron pipe at  
point of 1/4 cor.

U. W. Hasford

Signed

C. S. File No. 42/302