

T. 24S., R. 2W.

Renewal of section corner 14, 15, 22, & 23

Before logging in this area I found the two yew and ^{the one} cedar bearing trees, described in the original notes, in good condition. The original marked stone corner was gone, and the 40" fir B. T. was a windfall.

After logging only the original cedar bearing tree remained. From this tree I determined the position of the corner and drove a 2" iron pipe 30" long 18" in ground, from which;

A hemlock 28" in diam. bears S.56 $\frac{1}{2}$ °E. 77.9 ft.

marked T24S R2W S23 PS 253 B. T.

A cedar 30" in diam. bears S.15°W. 15.8 ft. (orig. B. T.)


marked T24S R2W S22 PS 253 B. T.

A yew 12" in diam. bears N.70°W. 75.4 ft.

marked T24S R2W S15 253 B. T.

No suitable tree remained standing in N. E. quadrant.

Sept. 13, 1957

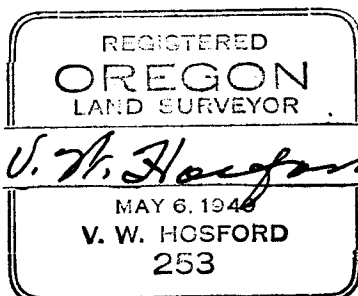

FILED
RECEIVED

OCT 8 1957

COUNTY SURVEYOR
DOUGLAS COUNTY, ORE.

G. S. File No. 73/306-6