

T. 25S., R. 2W., W.M.

Renewal of section corner 7, 8, 17, & 18

After logging in section 18 I found the original corner stone moved approximately two feet east from its original position. I did not re-set this stone. The original bearing tree for section 8 is a dead snag. The original B. T. for section 17 is entirely gone. The original B. T. for section 18 is a stump with scribing visible. The original B. T. for section 7 is in good condition. At the true point of the corner I drove a $1\frac{1}{2}$ " iron pipe 36" long, 24" in the ground, from which;

A red cedar 44" in diam. bears N. 4° E. 56.0 ft.

marked S 8 253 B. T.

A fir 60" in diam. bears S. 54° E. 51.5 ft.

marked S 17 253 B. T.


A hemlock 22" in diam. bears S. $32\frac{1}{2}^{\circ}$ W. 109.4 ft.

marked S 18 253 B. T.

A fir 48" in diam. bears N. 64° W. 56 links

original B. T.

Oct. 17, 1957

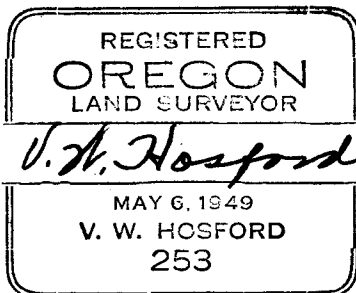

FILED
RECEIVED

OCT 22 1957

COUNTY SURVEYOR
DOUGLAS COUNTY, ORE.

200566

C. S. File No. 42/302