

Oct. 31, 1957

Sec. Cor. 23-24-25-26, T29S, R3W,
W.N. as det. by O.B.T. 5
30" La. Stump bears N50°E
29.7' dist. O.B.T.

44" Fir snag bears S35°W
~~21.1' dist.~~ 15.2' dist. O.B.T.

10" La. bears N64°W 21.1' dist.
fd. scribe (should be N72W 28.4')

At corner point set
1 1/4" x 24" Iron pipe
from which


9" La. bears N64°W 49.7'
dist. mkd. S23 T29S B.T.

6" Cedar bears N48°W 56.8"
dist. mkd. S23 R3W B.T.

10" La. bears N29W 39.2' dist.
mkd. S23 T29S R3W W.N. B.T.

9" Fir bears N22°W 22.9' dist.
mkd. S23 B.T.

Witness: R.G. Boyd

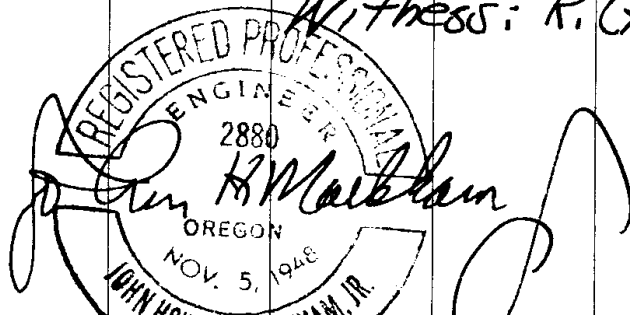

Work done for Starnes Lbr. Co.
10/31/57