

Oct. 29, 1957

1/4 Corner 24-25, T29S R3W, W.M.
as det. by O.B.T.

15" Fir snag N55°W 10.5' O.B.T.

36" Fir bears S39°W 23.7' O.B.T.


At corner point set 1 1/4" x 24" I.P.
from which

9" Fir bears S66°E 26.0' dist.
mhd. 1/4 S 25 B.T.

9" Fir bears S86°W 37.0' dist.
mhd. 1/4 S 25 B.T.

Witness:

R. G. Boyd.

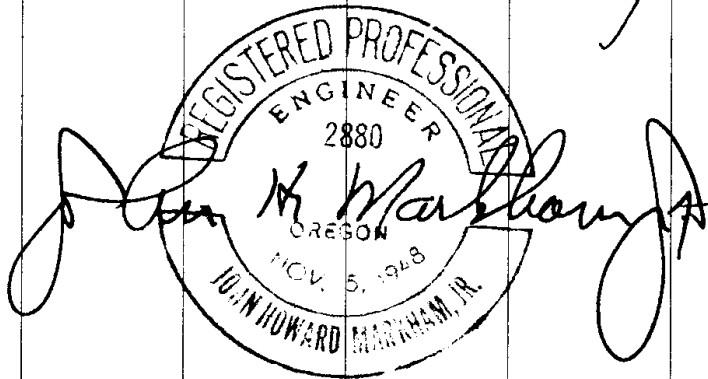

Work done for Stoman Lbr. Co.

✓ C. S. File No. 42/315³