

Oct. 29, 1957

1/4 corner 23-24, T29S R3W
W.M. as det. by O.B.T.S

24" Cedar bears S25°E 10.0' O.B.T.

13" Hemlock bears N79°W 11.0' O.B.T.

At corner point set 1 1/4" x 30"
truck axle with spline up.

from which.

10" Hemlock bears N53°E 20.5'
dist. mkd. 1/4 S 24 B.T.


15" Fir bears N31°W 26.5' dist.
mkd. 1/4 S 23 B.T.

Creek bears South 25.0' dist.

Road bears South 85.0' distance.

Witness:

R. G. Boyd.

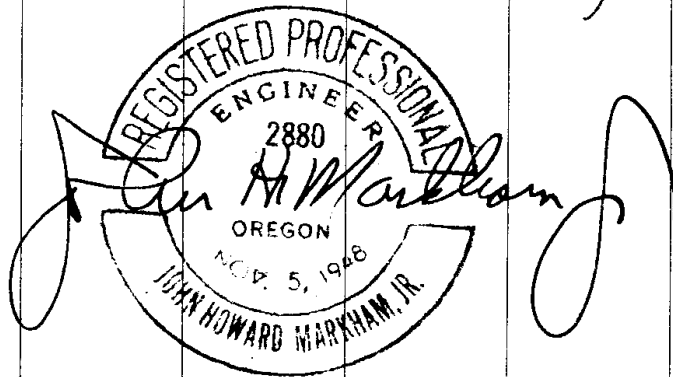

Work done for Stomar Lbr. Co.

C.S. File No. 12/315-10