


Weyerhaeuser Company

Section 25 Township 24 S. Range 3 W.

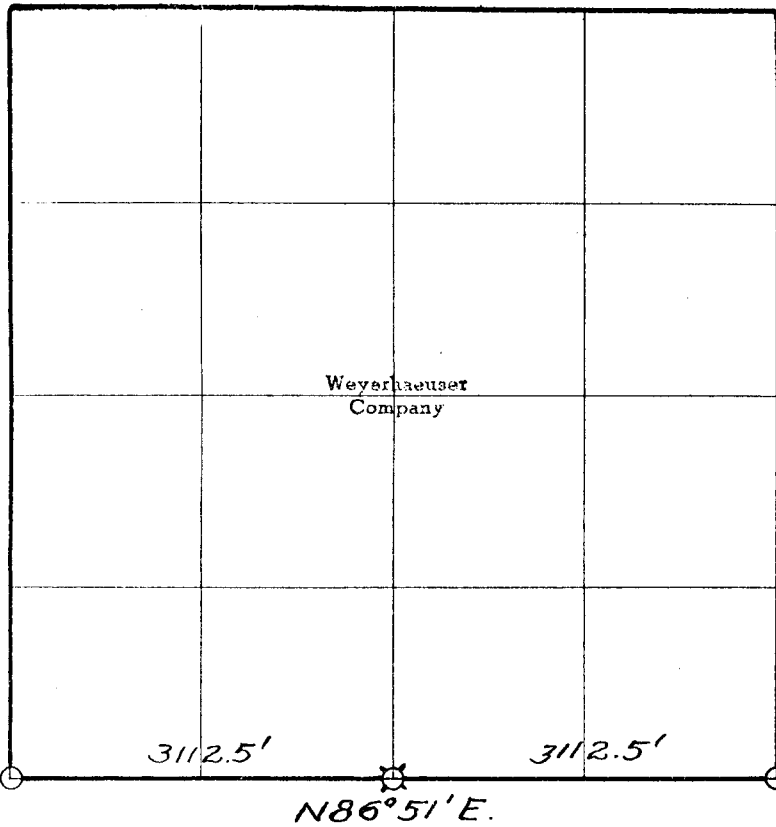

— # — # — Line marked by notch cut in blaze


- Known corner
- ⊗ Referenced corner

Transit and abney slope chain survey.

Bearings based on assumed 20° declination.

This survey was made for Weyerhaeuser Company by Marion D. Hale,
Oregon Licensed Land Surveyor, Reg. No. 243.

Helpers: S. McDuffie
B. Jackmond

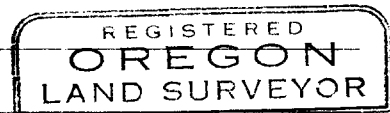

Marion D. Hale
 NOV. 5, 1948
MARION D. HALE
 243

Dates of survey September 1955 Date filed for record & where July, 1960

Distribution Douglas County Surveyor's Office

W. Co. - Spfld. Survey File
" Land Dept.
" Tacoma Land Records
Kenneth Ford - Roseburg

Reported May 20, 19 60
 By Marion D. Hale

$\frac{26}{35} | \frac{25}{36}$

Corner common to Sections 25, 26, 35 and 36-24S-3W.

GLO Survey Record

Found evidence of original GLO corner, but did not reference.

$\frac{25}{36}$

1/4 Corner common to Sections 25 and 36-24S-3W

GLO Survey Record.

No evidence of original GLO corner found.

Set 5/8" x 32" Monel pipe for corner by the single proportionate method.

Referenced by Marion D. Hale (Weyerhaeuser method).
Declination 20° E.

40" Fir Stp. S 32° E 28.7'
41" Fir Stp. N 30° E 42.2'

$\frac{25}{36} | \frac{30}{31}$

Corner common to Sections 25 and 36-24S-3W
30 and 31-24S-2W

GLO Survey Record

Found evidence of the original GLO corner, but did not reference.

WEYERHAEUSER TIMBER COMPANY CORNER REFERENCE METHOD

A "W" nail driven thru the hole in a brass disc, into a notch cut low on a tree, stamped with the Oregon registered land surveyor or professional engineer registration number. An embossed aluminum plate nailed head high on same tree with 8d aluminum nails, with distance and bearing from the "W" nail to the corner stamped on it.

