

RESTORED CORNER FOR STATE OF OREGON-DEPARTMENT OF FORESTRY

Closing Section corner common to Sections 3 and 4, T23S,
R10W, W.M., Coos and Douglas Counties, Oregon.

ORIGINAL

Fir Post (now missing) from which a:

- 12" Hemlock bears S59E 40 lks.; now down, scribes T2S R10 S3 visible.
- 7" Fir bears S81W 22 lks.; rotten root crown in place.

RESTORED


Set 1½" x 36" galvanized iron pipe with 3" bronze cap marked "OREGON STATE
BOARD OF FORESTRY S34 T22S R10W S4 S3 CC T23S R10W 1962 RS359", 30 inches
in ground, from which a:

- 24" Fir bears S80½E 23.1 ft.; scribed CC T23S R10W S3 BT RS359.
- 20" Hemlock bears S32W 32.5 ft.; scribed CC T23S R10W S4 BT.

Oregon State Forestry Department metal location poster on 24" Fir BT.
Set 4" x 4" x 72" white painted Cedar post 1.0 ft. SW of corner pipe.
Original Line blaze on 26" Hemlock, South 16.7 ft.

Dated March 20, 1962

Restored by Donald L. McConnell under my direction.
Donald L. McConnell, Transitman

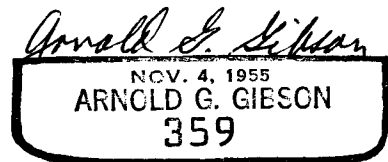

Present and witnessed by T. South
M. Pounds
D. Smith