

RESTORED CORNER FOR STATE OF OREGON-DEPARTMENT OF FORESTRY

One Quarter corner common to Sections 9 and 10, T23S,
R10W, W.M., Coos and Douglas Counties, Oregon.

ORIGINAL

Stone 24" x 20" x 20" (Found crumbled stone in place, no marks visible)
from which a:

12" Fir bears N15°E 15 lks.; now 37", face closed.

6" Fir bears N4°W 24 lks.; now 13" snag, scribes S9 exposed.

RESTORED


Set 1½" x 36" galvanized iron pipe with 3" bronze cap marked "OREGON STATE
BOARD OF FORESTRY 1/4 S9 S10 1962 RS359", 32 inches in ground, in mound
of stone, and from which a:

24" Fir bears N57½W 50.8 ft.; scribed 1/4 S9 BT RS359.

Oregon State Forestry Department metal location poster on Original 12" Fir BT.
Set 4" x 4" x 72" white painted Cedar post 2 feet NW of corner pipe.

Dated June 19, 1962

Restored by Donald L. McConnell under my direction.
Donald L. McConnell

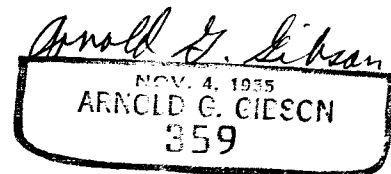

Present and witnessed by T. South
M. Pounds
D. Smith

FILED
RECEIVED

JUL 2 1962

COUNTY SURVEYOR
DOUGLAS COUNTY, ORE.