


REPORT ON

CORNERS OF THE CADASTRAL SURVEY GRID

T. 26 S. R. 9 W., Will. Mer., Oregon State.

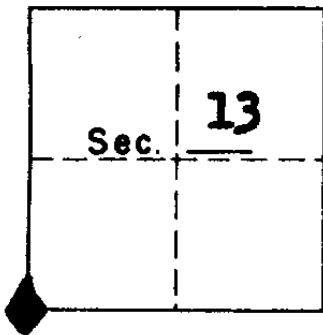

SYMBOLS



Official corner found.



Corner found, authenticity doubtful.



Corner searched for and not found.

DESCRIPTION OF CORNER MONUMENT.

**Did not find actual corner monument
One positive BT**

DESCRIPTION OF BEARING TREES, MOUND OF STONE, ETC.

**1 live Douglas fir 46" - bark scribe (T.26S KYM)
Would be BT for Sec. 24. Cor. is approx. 20° NW
(tag on side of road)**

**3 other live Douglas fir with marks on them that
don't appear to be authentic scribes but are in
proper positions.**

DESCRIPTION OF LOCATION TO ENABLE RECOVERY BY OTHERS.

**On side of Cold Springs road is tag marked 20° NW
to cor. Tag is on BT mentioned.**

4/23/57

Date

Reported By

Signature

Paul A. Stevens

Forester

Title

42/332