


REPORT ON

CORNERS OF THE CADASTRAL SURVEY GRID

T. 26 S. R. 9 W., Will. Mer., Ore. State.

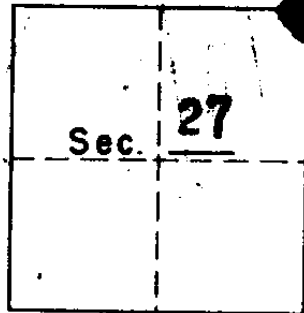

SYMBOLS



Official corner found.



Corner found, authenticity doubtful.



Corner searched for and not found.

DESCRIPTION OF CORNER MONUMENT.

3 Bearing Trees only as described below

DESCRIPTION OF BEARING TREES, MOUND OF STONE, ETC.

- S. 27 BT - 21" live Hemlock - face is showing - formerly chopped out to be visible.
- S. 23 BT - 34" Douglas fir snag - bark scribe at 4 1/2' little legibility (T. 26 S, R 9 W BT) Vertical scribe
- S. 22 BT - 23" live Hemlock - we chopped out overgrowth to expose face of which none was previously visible.

DESCRIPTION OF LOCATION TO ENABLE RECOVERY BY OTHERS.

Poster showing line crossing will be put on road (Callahan-Cold Springs Rd.) 4 1/2 T. W of cor. hand compass and pacing.

Reported By Paul Stevens
 Signature
Forester
 Title

4/25/57
 Date