


LOT 4 · BLOCK 2 · SYLMAN VALE TRACTS · ROSEBURG

Robt. M. Daly.

GARY LANE 40'

N 74° 30' W 119'

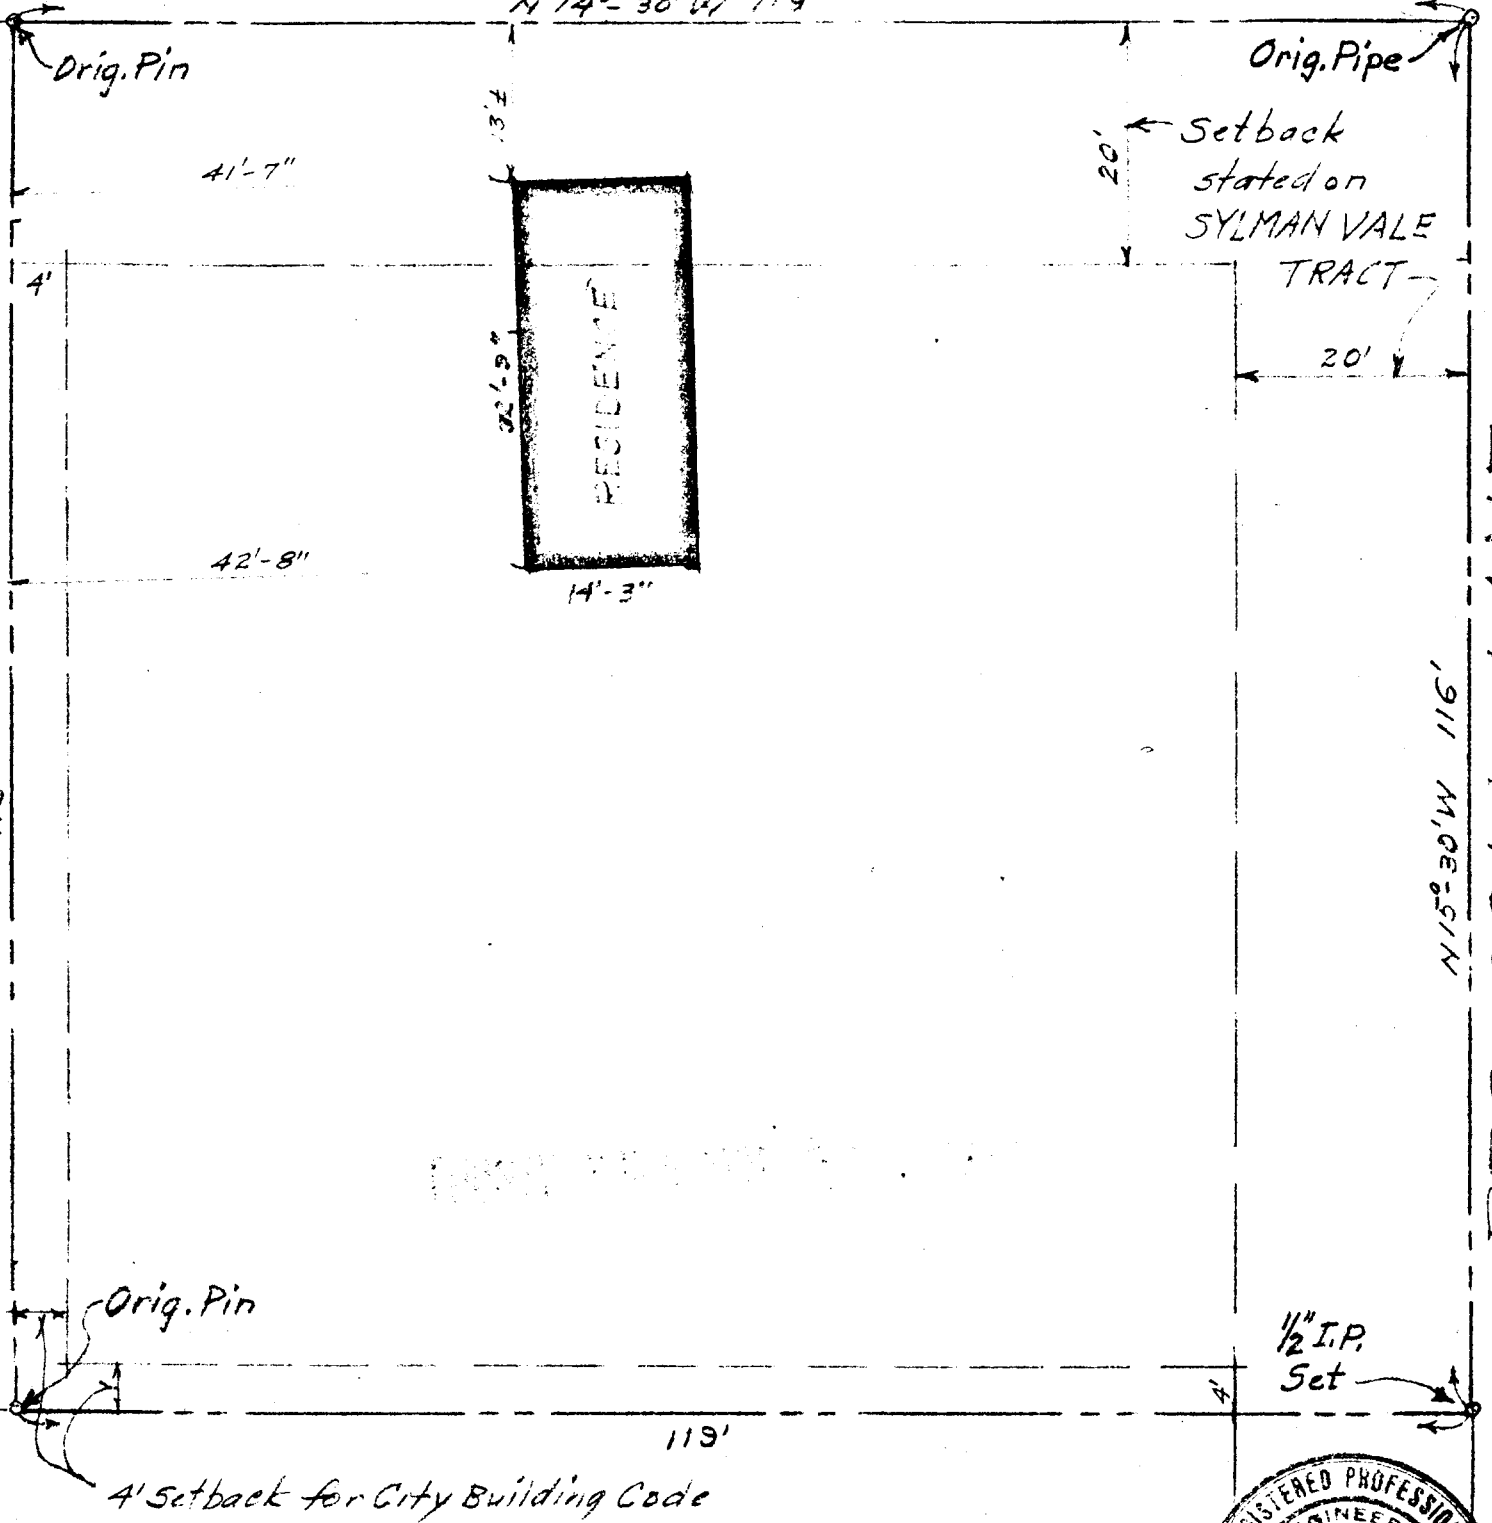


SCALE 1" = 16'

JAMES R. DAUGHERTY

CIVIL - SANITARY ENGINEER

ROSEBURG · ORE.

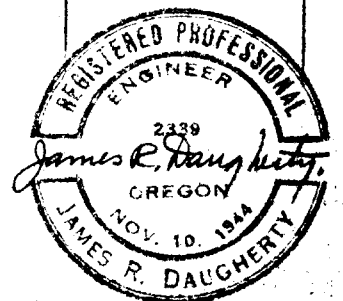

Corners Checked Feb. 5, 1955.
May 6, 1955.