

RESTORED CORNER FOR OREGON STATE BOARD OF FORESTRY

Closing corner common to Sections 4 and 9, T. 22S, (E. SIDE)
R. 11W, W.M., Douglas County, Oregon

ORIGINAL

Post (now missing, found ~~4x4x48~~" white cedar post in stone mound) from which a:

4" Fir bears S16W 39 lks.; now 26", uncovered burnt face, original axe work visible.

3" Fir bears N63W 51 lks.; now 28" stump, face unexposed, distance is 13.9'

8" Alder bears S57E 195 lks.; now missing.;

RESTORED

Var. 20 $\frac{1}{2}$ E

Set 1 $\frac{1}{2}$ " x 36" galvanized iron pipe with 3" bronze cap marked "OREGON STATE BOARD OF FORESTRY T22S R11W CC S4 S9 S10 1957 RS 359," 33 inches in ground, in mound of stone, and from which a:

20" Fir bears S52W 5.7 ft.; scribed T22S R11W S9 BT

28" Fir Stp.(orig.) bears N63W 13.9 ft.; scribed BT


26" Fir bears S86E 16.8 ft.; scribed RS 359

Set ~~4x4x48~~" white painted Cedar post 1.5' N of pipe.

Oregon State Board of Forestry metal location poster on 28" Fir stp. BT.

Dated January 3, 1958.

Restored by Elbert Driver under my direction.
Elbert Driver, Transitman

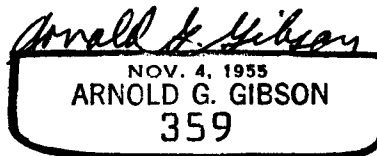

Present and witnessed by Derald Timmons
Ron Witham

FILED
RECEIVED

FEB 24 1958

COUNTY SURVEYOR
DOUGLAS COUNTY, ORE.

C. S. File No. 42/340²