

ESTABLISHED CORNER FOR OREGON STATE BOARD OF FORESTRY

East One Sixteenth corner common to Sections 3 and 10,
T. 22S, R. 11W, W.M., Douglas County, Oregon.

ESTABLISHED

Var. $20\frac{1}{2}^{\circ}E$


Set $1\frac{1}{2}$ " x 36" galvanized iron pipe with 3" bronze cap marked "OREGON STATE BOARD OF FORESTRY E 1/16 S3 S10 1958 RS 359," 33 inches in ground, in mound of stone, and from which a:

58" Maple (clump) bears $N61\frac{1}{2}^{\circ}E$ 106.7 ft.; scribed E 1/16 S3 BT RS 359.
Rock outcrop 6.5' x 4' high on low side bears $S17\frac{3}{4}^{\circ}W$ 28.2 ft.;
scribed X B0 on South edge.

Oregon State Board of Forestry metal location poster on 43" Maple (clump)
 $N18^{\circ}E$ 51.0'.

Dated January 27, 1958.

Established by

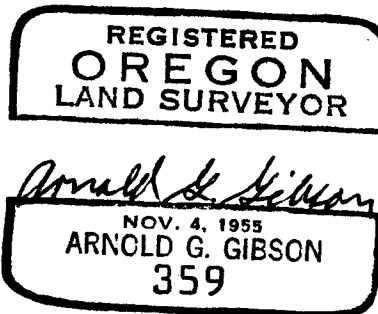

Present and witnessed by Derald Timmons
Ron Witham
Elbert Driver

FILED
RECEIVED

FEB 24 1958

COUNTY SURVEYOR
DOUGLAS COUNTY, ORE.

O.C.S. File No. 12/340³