

RESTORED CORNER FOR OREGON STATE BOARD OF FORESTRY

Section corner common to Sections 3 and 10 (East side), T. 22S, R. 11W, W.M., Douglas County, Oregon.

ORIGINAL

Post in stone mound (Post missing and stone mound disturbed by uproot).

RESURVEY by William Whipple, 1893

Stone 20 x 12 x 10" (now missing)

RESTORED by Wilford Haines, January 1956.

36" angle iron with brass cap (found in place 1" sheet metal cap) from which a:

12" Fir N20W 26.0'; now 13", scribes T22S R11W S3 BT visible.

RESTORED

Var. 20 $\frac{1}{2}$ °E

Set 1 $\frac{1}{2}$ " x 36" galvanized iron pipe with 3" bronze cap marked OREGON STATE BOARD OF FORESTRY T22S R11W S3 S10 S11 1958 RS 359," over above angle iron, 33 inches in ground, in mound of stone, and from which a:

11" Madrone bears N51W 43.4 ft.; scribed T22S R11W S3 BT

28" Fir bears N85 W 53.5 ft.; scribed RS 359


17" Fir stump bears S50W 12.5 ft.; scribed T22S R11W S10 BT

Set 4x4x48" white painted cedar post 1.0' SW of pipe.

Oregon State Board of Forestry metal location poster on 10" Fir N81E 25.2'.

Dated January 27, 1958.

Restored by Elbert Driver under my direction.
Elbert Driver, Transitman

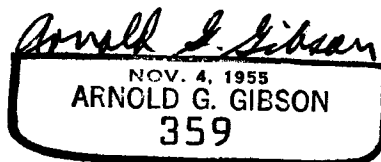

Present and witnessed by Derald Timmons
Ron Witham

FILED
RECEIVED

FEB 24 1958

COUNTY SURVEYOR
DOUGLAS COUNTY, ORE.

C.S. FILE No 42/340-5