


COUNTY SURVEYORS FIELD DATA
DO NOT REMOVE FROM OFFICE

PROPERTY LINE SURVEY
FOR
DEED DESCRIPTION
SEC. 18, T. 25 S., R. 5 W., W. M.
SCALE 1" = 200'

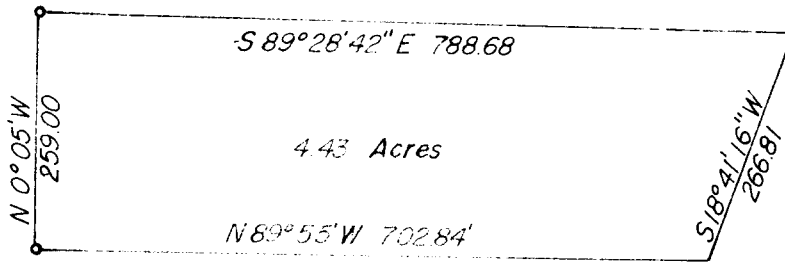

INITIAL POINT bears
North 2204.4' & N 89° 55' W 820.9'
from S.E. exterior corner Levi Knott D.L.C. 53
Vol. 228, Pg. 68

County road No. 154
40' R/W

I, R.H.GEE, do hereby certify that this survey was made by me for John J. Grabow on Feb. 17, 1958, for subdivision of property.

R. H. Gee

R. H. Gee

FILED
RECEIVED
COUNTY SURVEYOR
OFFICE