

Dec. 2, 1959

1/4 Corner 4 & 9 T295 RAW. W.M.

● At midpoint set 1/2" x 36" I.P.
from which

9" Fir S60E 12.0' '45 9 X B.T.

● 10" Fir N10E 24.2' '45 4 B.T.


10" La. N39W 10.3' '45 T295 RAW B.T.

10" La. S6W 10.5' '45 9 T295 RAW B.T.

● S.E. Cor. 4 bears S81°35'E 2090.0'

S.W. Cor. 4 bears N81°35'W 2090.0'

Corner lies on West nose of high
ridge. Witness: R.G. Boyd.

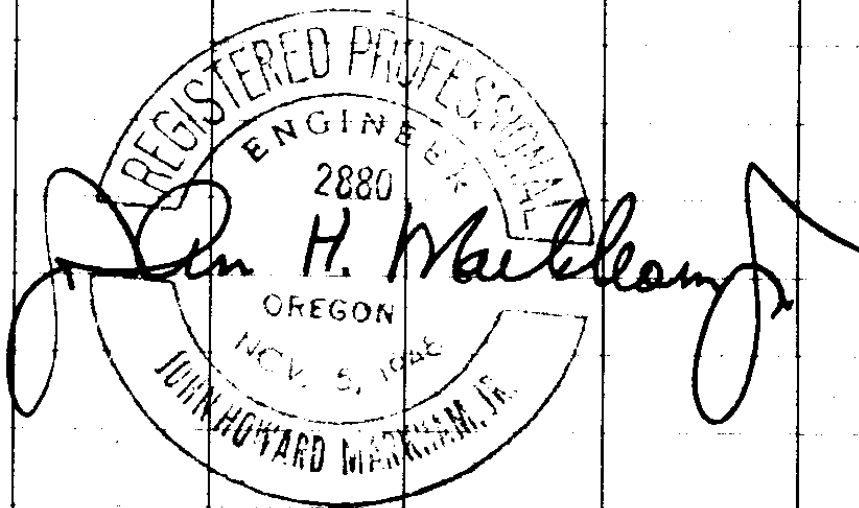

Work done for Stoman Lbr. Co.

C. S. File No. 42/345-6