


COUNTY SURVEYORS FILE DATA  
DO NOT REMOVE FROM OFFICE

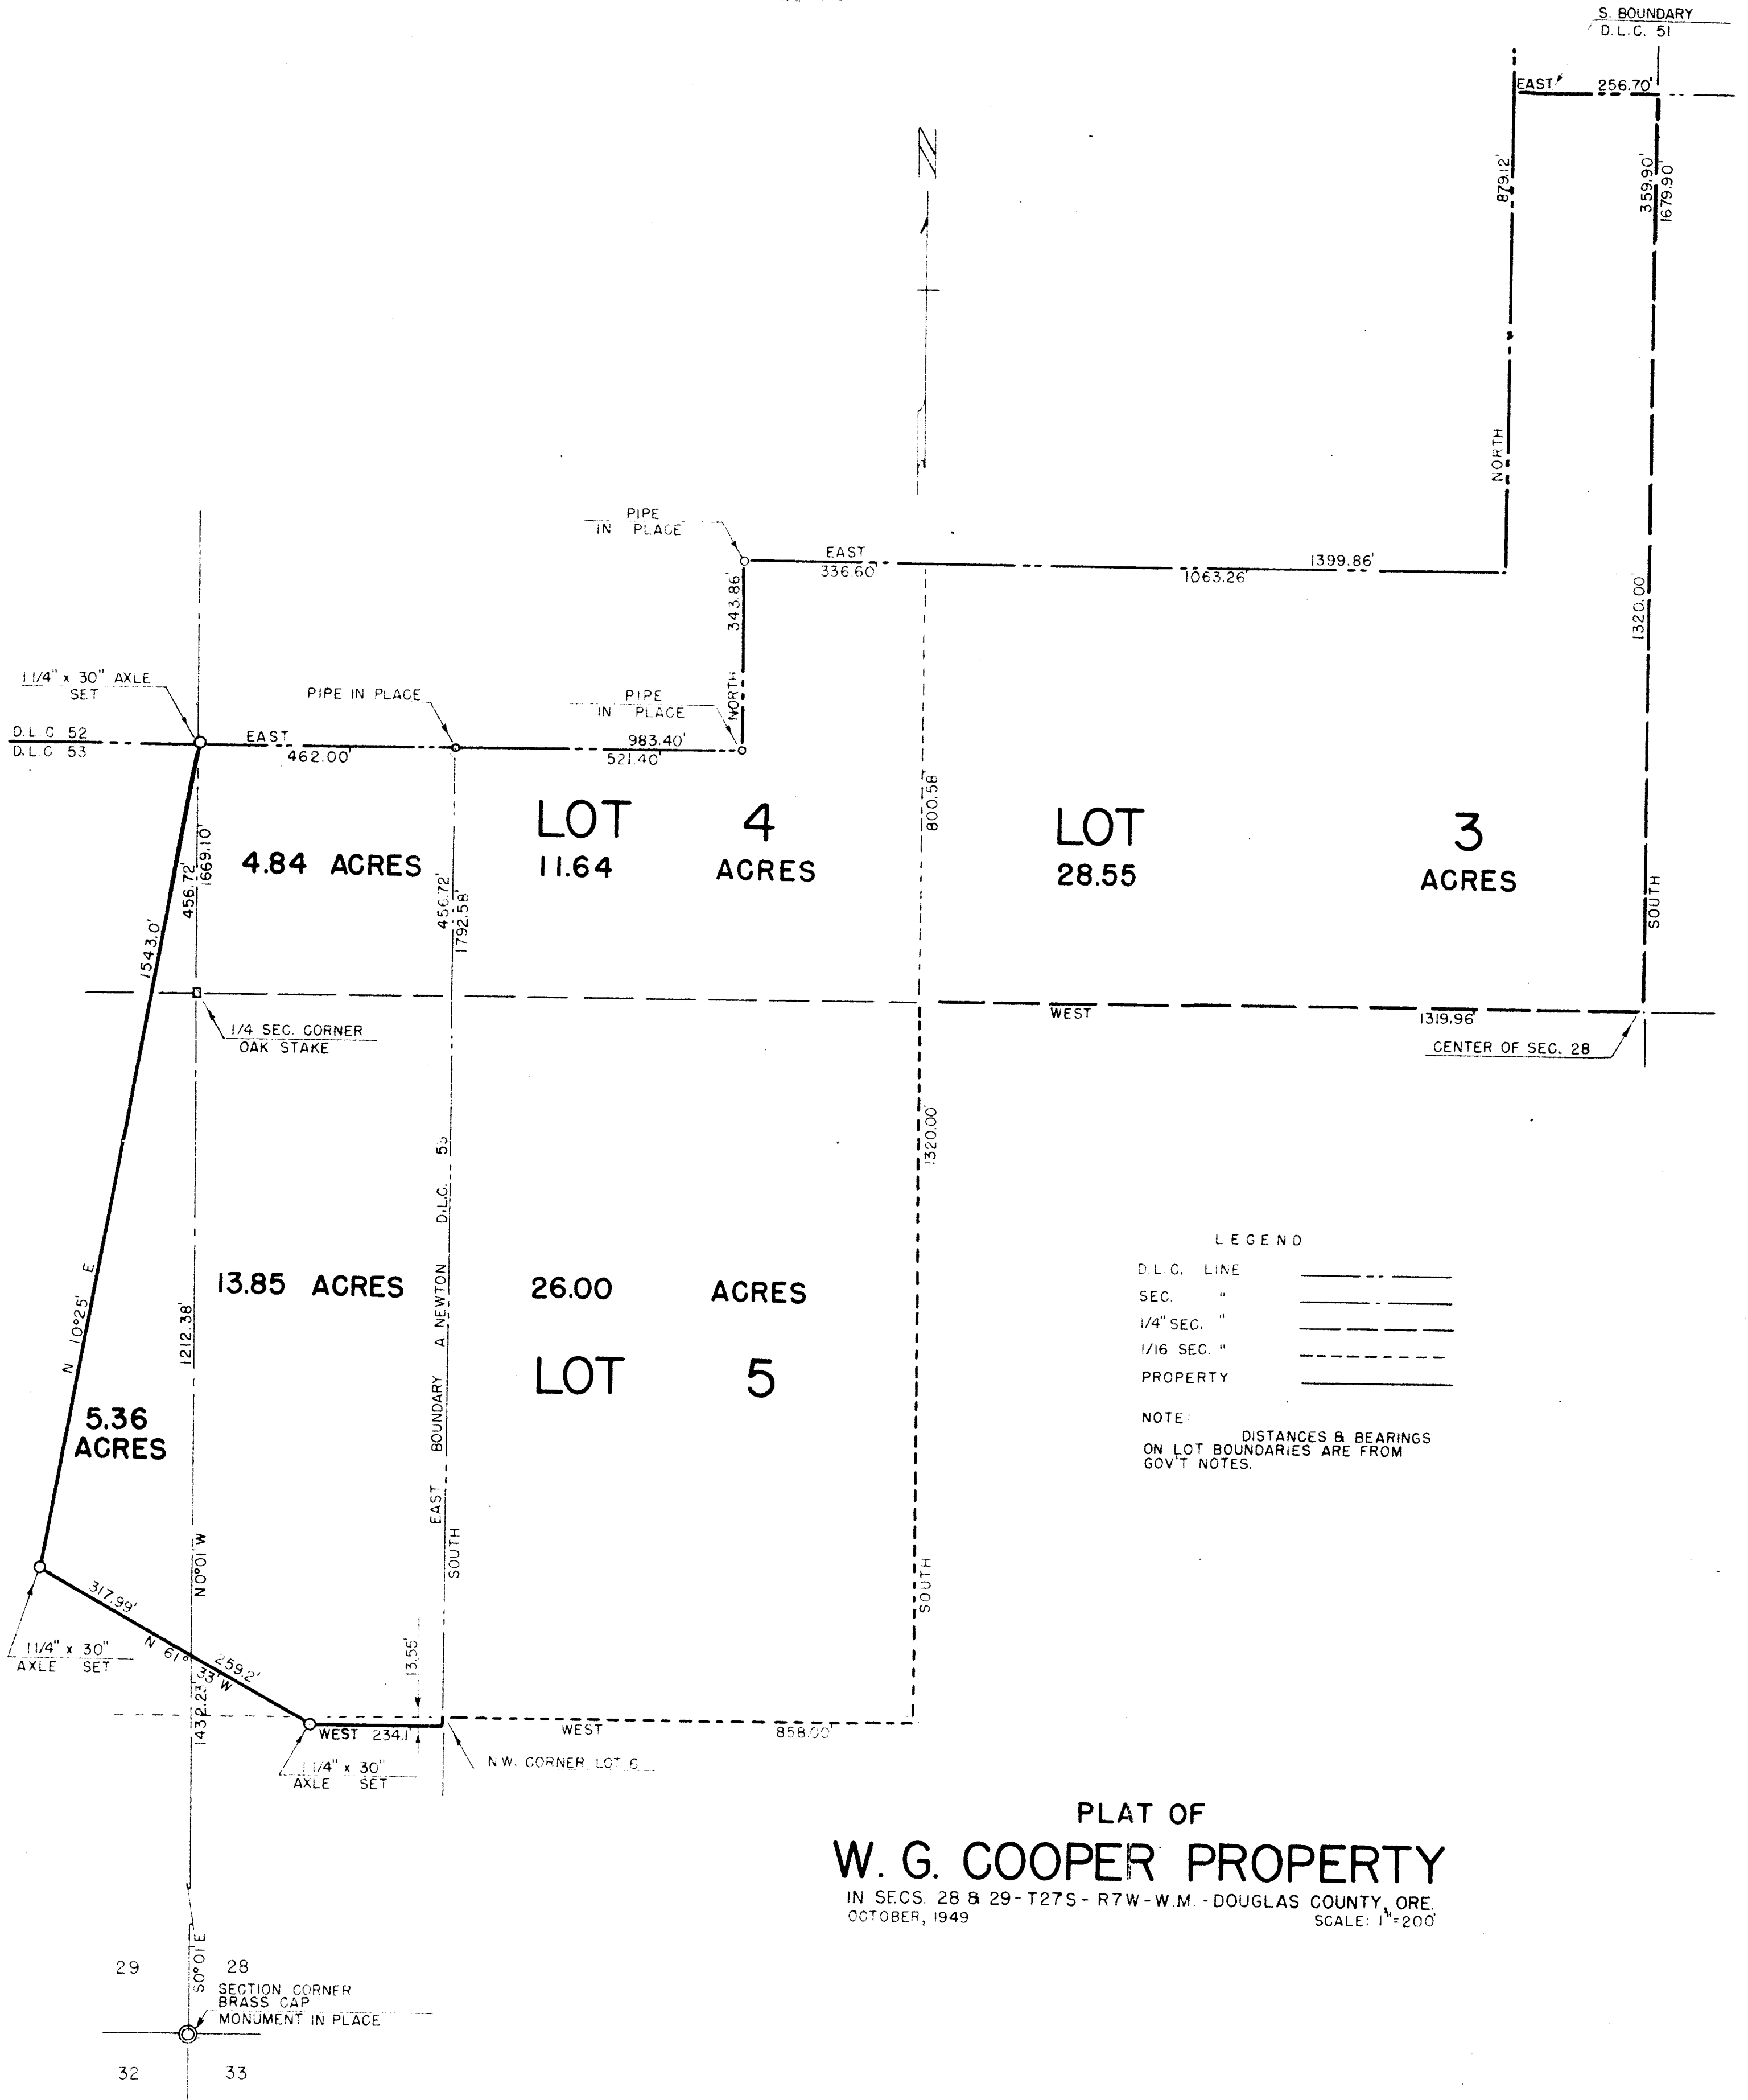

COUNTY SURVEYORS FILE DATA  
DO NOT REMOVE FROM OFFICE

File No. 42/346