


LOT 12 · BL. 2 · BROWN'S FAIR ACRES · WEST ROSEBURG
DOUGLAS COUNTY · OREGON

Douglas County Realty

BROWN AVE. 45'

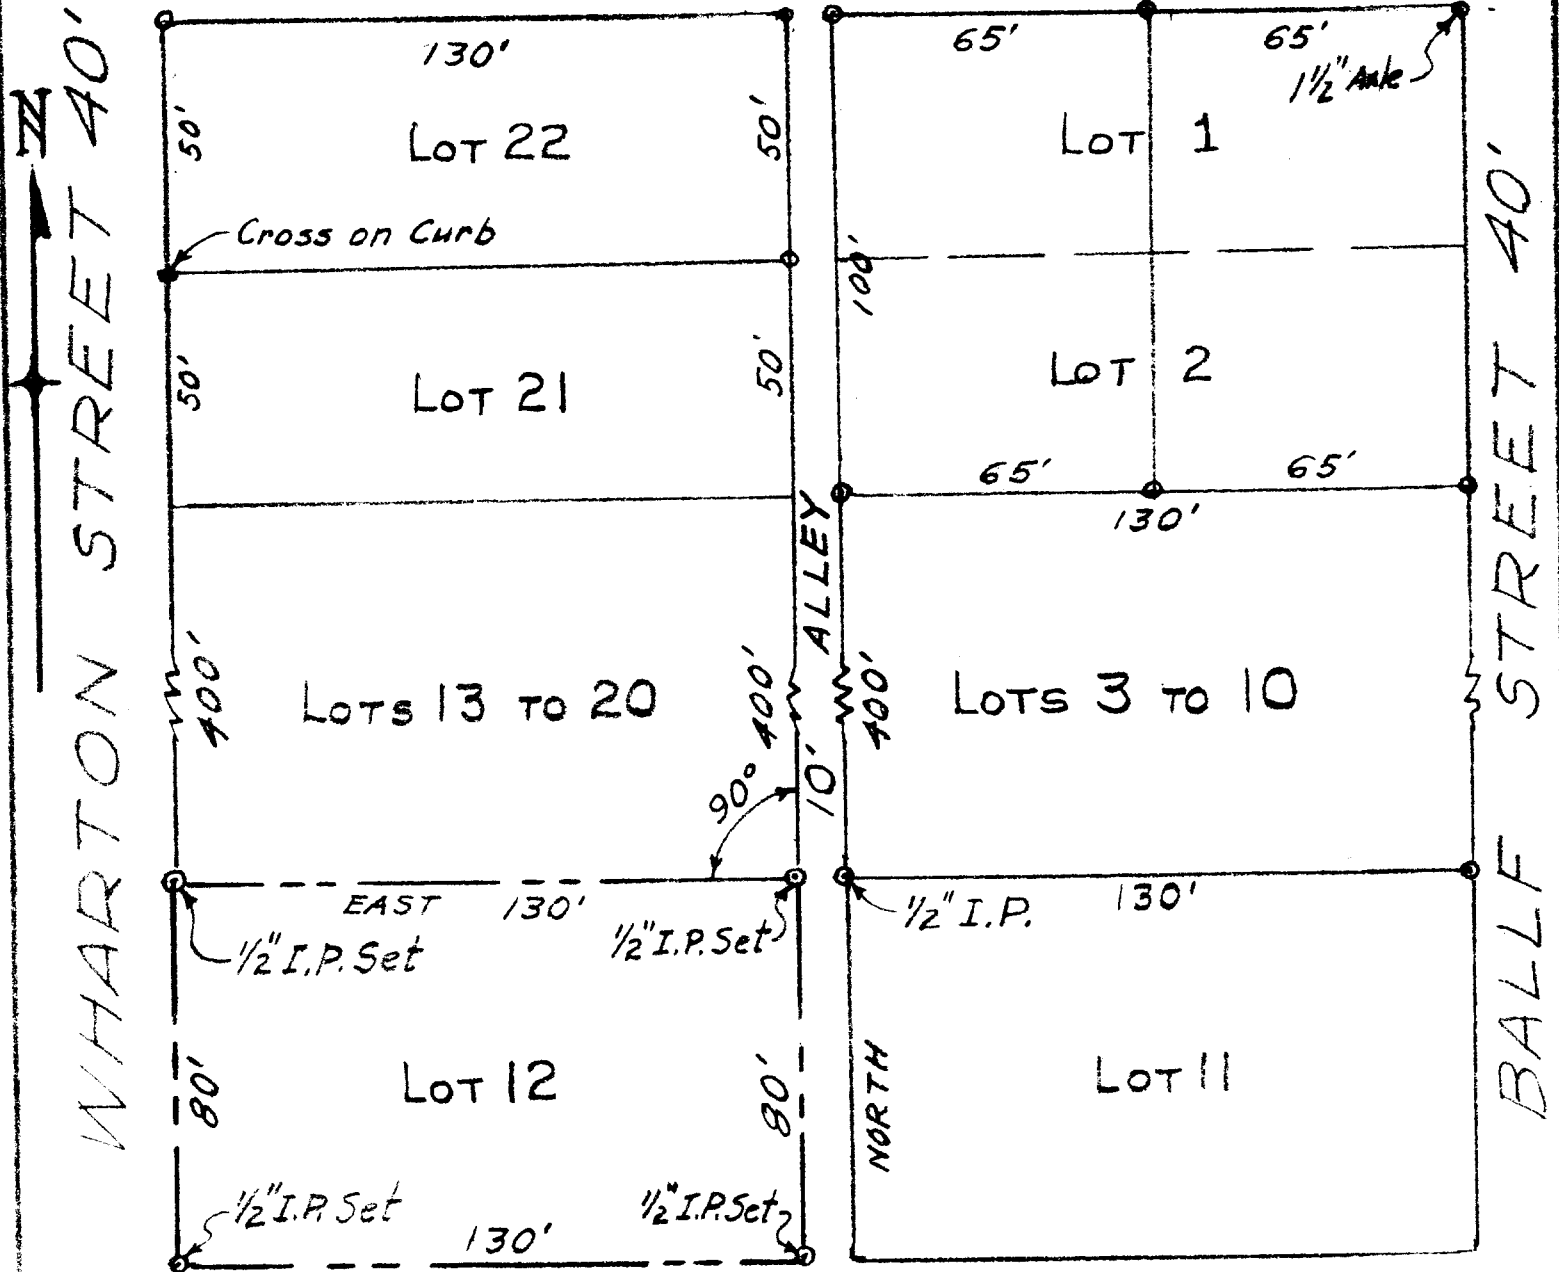

MYRTLE AVENUE 40'


SCALE 1" = 40'

SURVEYED BY

JAMES R. DAUGHERTY

CIVIL-SANITARY ENGINEER

ROSEBURG · ORE.

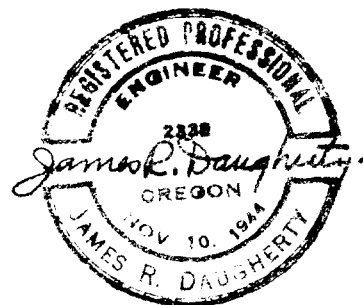

MAY 5, 1958.