

Feb. 22, 1959

S.E. Corner Section 34, T30S  
R4W, W.M.

At a point 198.0' East of  
N.W. Corner Sec. 2, I set  
3/4" x 30" I.P. for S.C.

from which

8" La. bears S60E 27.5' dist.

mkd. 52 T31S R4W BT

30" cedar bears S40W 18.5' dist.

mkd. 52X B.T.

6" La. bears N77W 19.0' dist.


mkd. 534 B.T.

5" Fir bears N18E 13.8' dist.

mkd. 535 B.T.

Sec. Cor. 3/4" bears West 198.0'

Witness R.G. Boyd

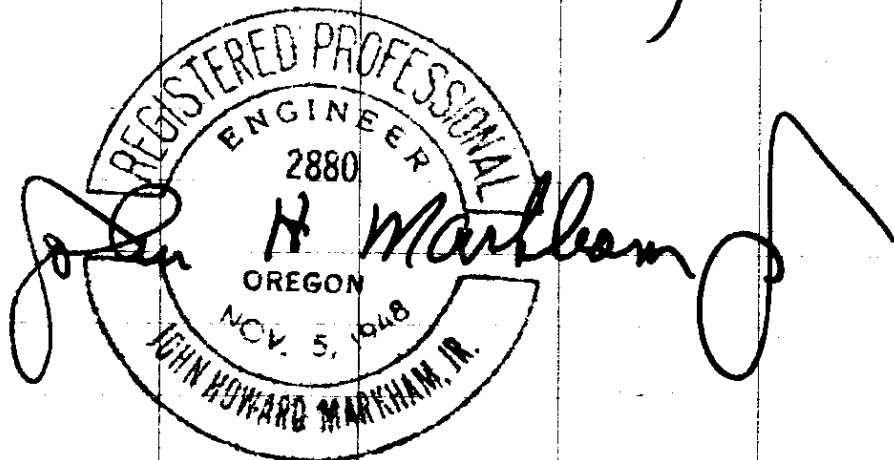

Work done for Stoman Lbr Co.

✓ C. S. File No. 92/356<sup>8</sup>