

Sept. 9, 1959.

South 1/4 corner, Section 14  
only, T32S R3W, W.N.R. as  
det. by O.B.T.S.

28" Fir stump (Logged) bears  
N22E 15.8' dist. O.B.T. - I  
rescribed '4514 B.T.

24" Fir, stump bears N22W 22.4'  
O.B.T. - I rescribed '4514 B.T.

At corner point found original  
stone and set 3/4" x 30" I.P.


From which

26" Fir stump (Logged) bears  
S22W 15.5' dist. Inkd. '45 B.T.

End of spur road and landing  
bears S44W approx 450.0' dist.

Witness: H.C. Stokes

(OVER)

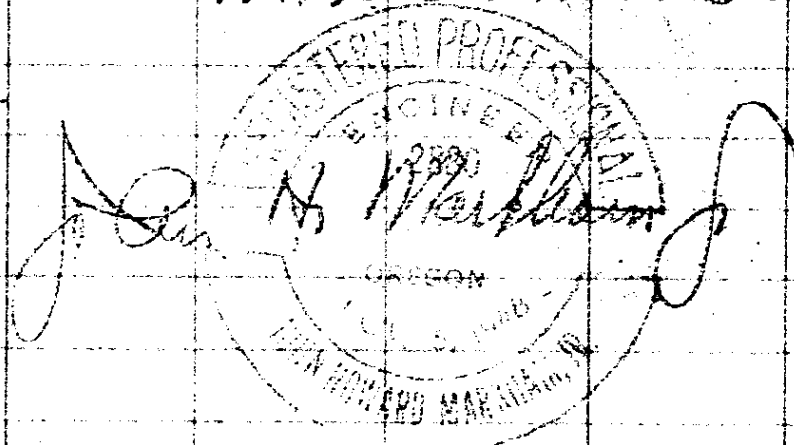

✓ ✓ U.S. file no. 42/356-15

Work done for N & B Logging Co.

Corner lies in clear  
cut high lead logging  
and there are no larger  
trees left.

FILED

RECEIVED

SEP 7 1959

COUNTY SURVEYOR  
DOUGLAS COUNTY, ORE.