


Oct 13, 1959

- $\frac{1}{4}$  Corner 33 & 34 T305  
R4W W.M. as det. by O.B.T.S.  
30" Fir N42E 7.3' dist. O.B.T.  
15" Fir N56W 6.6' dist. O.B.T.

- At corner point set  
 $\frac{1}{2}$ " x  $\frac{1}{2}$ " x 30" angle Iron  
from which.

- 5" La bears S13E 22.7'  
dist. mhd. '4534 B.T.  
5" Alder bears N69W 15.5'  
dist. mhd. '4533 ~~B.T.~~  
18" Fir bears North ~~47~~ dist.  
mhd. '45 B.T.

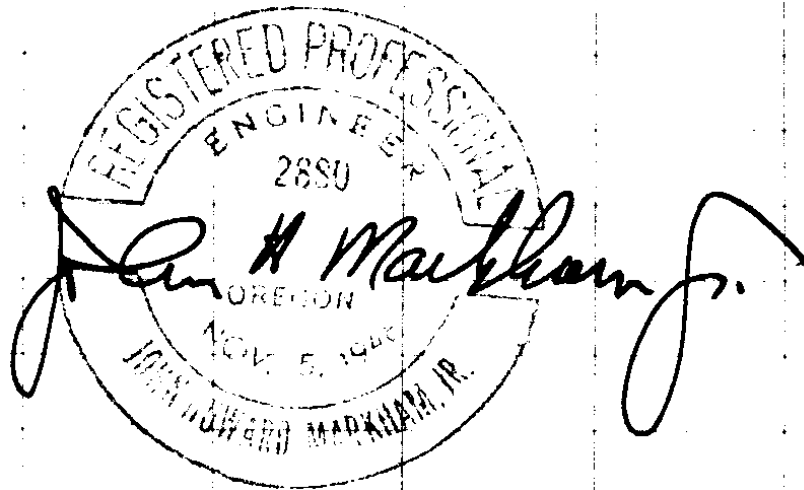

Work done for Stroman Lbr Co.

✓ C. S. File No. 72/356-14