

Nov. 9, 1959

1/4 Corner 23-26, T32S R3W
as det. by O.B.T.S

42" Fir N50E 50.0' O.B.T.

36" Cedar S37W 22.0' O.B.T.

At cor. pt. set 1" X 30" I.P.
and found stone.


from which

6" W. Fir bears S69E 8.3' dist.
mhd. '14526 B.T.

10" Fir bears N71E 9.0' dist.
mhd. '14523 B.T.

Road bears West 272.0'

Witness: S. J. Pritchett

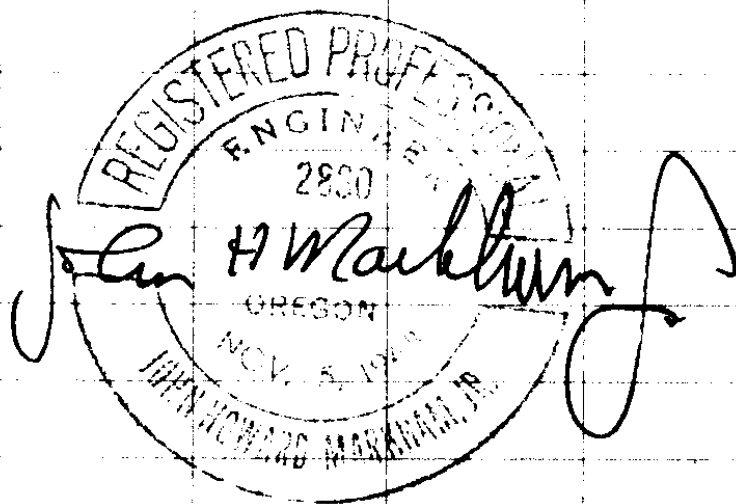

Work done for M & B Logging Co.

U. S. File No. 43/356-18