

Nov. 9, 1958

N.W. Corner Sec. 24, T32S R3W
as det. by O.B.T.

36" Fir Stump (Logged) bears
55.5°E 12.5' O.B.T. I

rescribed S24 on top of B.T. on bark.

At corner pt. set truck
axle with flange up.


from which

10" W. Fir bears S46E 68.0'
dist. mkd. S24 B.T.

12" Fir bears S68E 144.0'
dist. mkd. S24 B.T.

Road bears East 165.0'

Witness: S. J. Pritchett

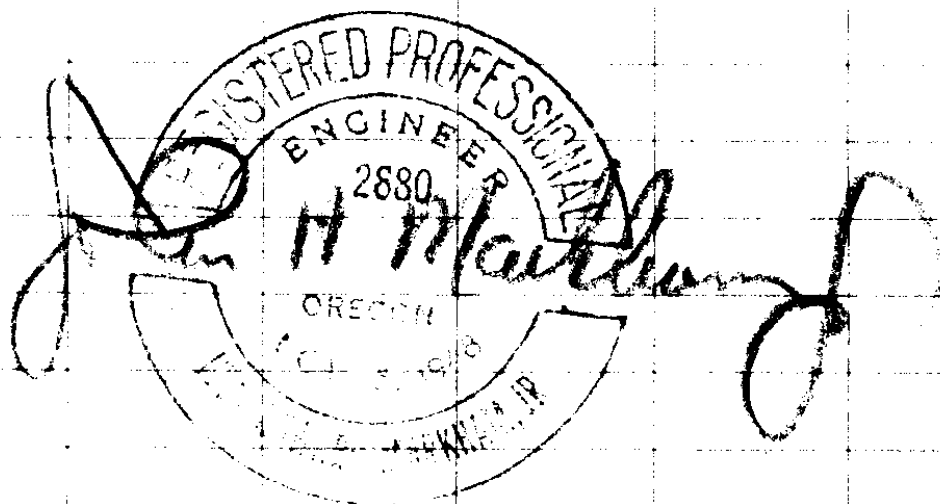

Work done for M & B Logging Co. 19

C. S. File No.

42/356