

Aug 3, 1960

1/4 corner 3/34 T 305 - T 315

- RAW as det. by O.B.T.S.
- 40" Fir SSE 2.6' O.B.T. fd. scribe on bark & rescribed 1/4 S 3 B.T.
- 30" Cedar N27E 6.0' dist. O.B.T.
- I rescribed 1/4 S 34 B.T.


At cor. pt. set stone from which

14" Chip bears S62W 33.5' dist. mkd. 1/4 S 3 RAW B.T.

- 10" La bears S52W 24.5' dist. mkd. 1/4 S 3 T 315 RAW B.T.

✓ Witness: R. G. Boyd

R. G. Boyd

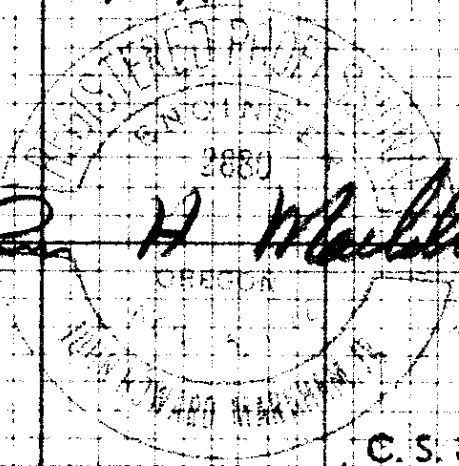

C.S. File No. 12/356²

Note: This is not a 1/4 corner

- to either section, but rather a point on Twp. Line since both sections had closing corners.
- Work done for *Standa*