

Aug 3, 1960

1/4 corner 27-28 T305 RAW
● set from field notes taken
by me before road con-
struction. Corner point falls
in road & both O.B.T. were
destroyed.

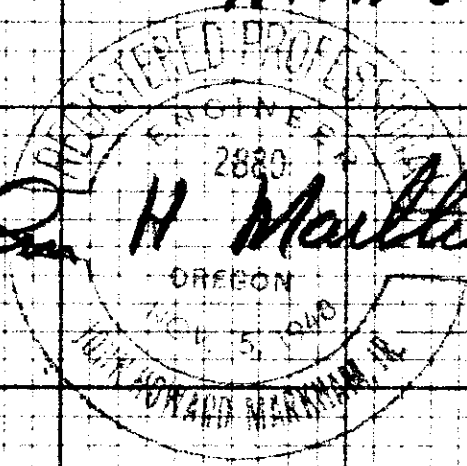
From corner point:

8" La. N26W 30.0' mkd 1/4 S 28 T305
RAW B.T.

30" Fir N25E 17.3' mkd 1/4 S 27 B.T.

● 9" La. bears S67E 31.0'
dist. mkd. 1/4 S 27 RAW B.T.

Witness: R. G. Boyd.


H. Moulton

✓✓ C.S. File No. 42/356⁻²²

Work done for Stearns Land