

AUG 5, 1960

1/4 Corner 26/27 T305 R4W


- as det. by O.B.T.S.
- 36" Fir Stump (Logged) bears N47E 9.6' dist. O.B.T. f.d. scribe
- 26" Fir Stump (Logged) bears North 19.5' O.B.T.

At corner point found dead 22" Fir snag scribed on West face & set 3/4" x 40" I.P.

from which

- 12" La. bears S80W 39.0' dist. mkd. 1/4 3 27 T305 R4W B.T.
- 12" Chip. bears S43W 34.3' dist. mkd. 1/4 3 27 B.T.
- 12" Fir bears S11W 21.7' dist. mkd. 1/4 5 26 B.T.
- 3" Fir bears S50E 8.0' 1/4 5 B.T.

Witness: J. R. Markham

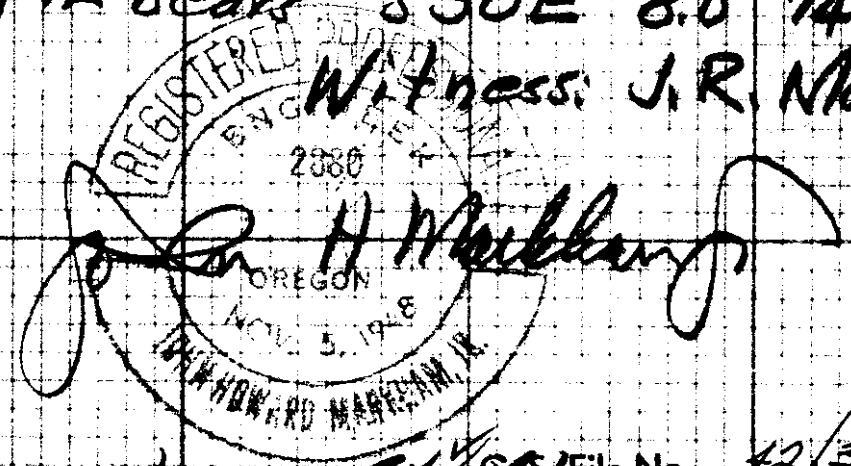

Work done for *[illegible]* File No. 42/356-24